FILED LMLMS1320 M70974 2004-02-17-14.01.34.050263

STRATA PLAN OF LOT 1, SECTION 22, BLOCK 5 NORTH, RANGE 2 WEST, PLAN LMP 8371, NEW WESTMINSTER DISTRICT.

B.C.G.S. 92G . 016
ACCORDING TO PLAN LMP 8371

0 5 10 20 30 40 50
SCALE 1 : 750

CIVIC ADDRESS :-
WHALLEY POINTE I
(PARKVIEW COURT)
10838 134 th STREET
SURREY B.C.

THE ADDRESS FOR SERVICE OF DOCUMENTS ON THE STRATA TITLE IS :-
~~THE OWNERS~~
~~C/O THE OWNERS STRATA PLAN LMS 1328~~
~~SUITE 550 — 999 CANADA PLACE,~~
~~WORLD TRADE CENTRE,~~
~~VANCOUVER B.C.~~
~~V6C 3C8~~
DORSET REALTY GROUP CANADA LTD.
200 - 8211 ACKROYD ROAD
RICHMOND, B.C. V6X 3K8
SEE DF BP 144239

MURRAY & ASSOCIATES
201-12448 82nd AVENUE
SURREY, B.C.
V3W 3E9
(604) 597-9189

LOCATION PLAN AND DIMENSIONS

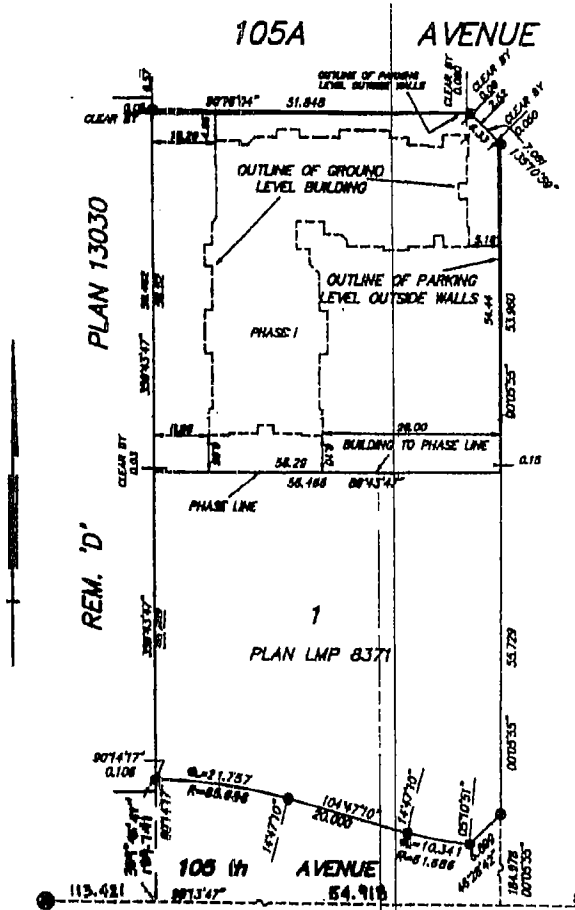

THIS PLAN LIES WITHIN THE GREATER VANCOUVER REGIONAL DISTRICT

FIRST SHEET SHEET 1 OF 11 SHEETS

STRATA PLAN LMS 1328
PHASE I

DH 126539

DEPOSITED AND REGISTERED IN THE LAND TITLE OFFICE AT NEW WESTMINSTER BRITISH COLUMBIA, DATED THIS 1st DAY OF MARCH 1994.
Authorized Deputy REGISTRAR

- (A) DENOTES CONTROL MONUMENT FOUND
- ● DENOTES STANDARD IRON POST FOUND
- SL DENOTES STRATA LOT
- m² DENOTES SQUARE METRES
- P DENOTES PATIO AREA
- B DENOTES BALCONY
- PS DENOTES PARKING STALL (LIMITED COMMON PROPERTY)
- PST DENOTES PARKING STALL (COMMON PROPERTY)
- VP DENOTES VISITOR PARKING STALL (COMMON PROPERTY)
- (C) DENOTES COMMON PROPERTY
- HC DENOTES HANDICAP PARKING STALL (COMMON PROPERTY)

ALL DIMENSIONS ARE IN METRES
ALL ANGLES ARE 45 OR 90 DEGREES UNLESS INDICATED OTHERWISE

AREAS INDICATED AS P, B OR PS ARE LIMITED COMMON PROPERTY APPURTENANT TO THE STRATA LOT INDICATED THUS : P - 9, B - 32 OR PS - 9

LIMITED COMMON PROPERTY IS NOT INCLUDED IN THE UNIT ENTITLEMENT.

FORM C - DH 126538

I, RAYMOND HAROLD JANZEN, OF DELTA, BRITISH COLUMBIA LAND SURVEYOR, HEREBY CERTIFY THAT THE BUILDINGS ERECTED ON THE PARCEL DESCRIBED ABOVE ARE WHOLLY WITHIN THE EXTERNAL BOUNDARIES OF THAT PARCEL. DATED AT SURREY, B.C. THIS 2nd DAY OF MARCH , 1994.

B. C. L. S.

FILE 7995

FILED LMLMS1328 M70974 2004-02-17-14.01.34.850263

SECOND SHEET SHEET 2 OF 11 SHEETS

CONDOMINIUM ACT

STRATA PLAN LMS 1328
PHASE I

STATUTORY DECLARATION

I/WE THE UNDERSIGNED DO SOLEMNLY DECLARE THAT :

1) I/WE THE UNDERSIGNED (AM/ARE) THE OWNER-DEVELOPER OR (IN THE ALTERNATIVE) THE DULY AUTHORIZED AGENT OF THE OWNER-DEVELOPER

2) THE STRATA PLAN IS ENTIRELY FOR RESIDENTIAL USE

I/WE MAKE THIS SOLEMN DECLARATION CONSCIENTIOUSLY BELIEVING IT TO BE TRUE AND KNOWING THAT IT IS OF THE SAME FORCE AND EFFECT AS IF MADE UNDER OATH

DECLARED BEFORE ME
AT VANCOUVER
IN THE PROVINCE OF BRITISH COLUMBIA
THIS 31st DAY OF MARCH
1994.

STEPHEN Y.W. LEUNG

A NOTARY PUBLIC IN AND FOR THE PROVINCE OF BRITISH COLUMBIA
A COMMISSIONER FOR TAKING AFFIDAVITS WITHIN BRITISH COLUMBIA

ACCEPTED AS TO FORMS 1, 2, AND 3.
DATED THIS 12 DAY OF April 1994

for SUPERINTENDENT OF REAL ESTATE

APPROVED AS PHASE I OF A II PHASE
STRATA PLAN UNDER THE CONDOMINIUM ACT.
DATED THIS 7 DAY OF April, 1994.

APPROVING OFFICER FOR THE
CITY OF SURREY

I HEREBY CERTIFY THAT THE COMMON FACILITIES, BEING :
RECREATION FACILITIES
WHICH, ACCORDING TO FORM E TO THE ACT, WERE TO HAVE BEEN CONSTRUCTED IN CONJUNCTION WITH THIS PHASE, HAVE BEEN SATISFACTORILY PROVIDED FOR.
DATED THIS 7 DAY OF April, 1994.

APPROVING OFFICER FOR THE
CITY OF SURREY

MURRAY & ASSOCIATES
201-12448 82nd AVENUE
SURREY, B.C.
V3W 3E9
(604) 597-9189

AS TO MORTGAGE ANF ASSIGNMENT OF RENTS
HONGKONG BANK OF CANADA

ALBERT S/N 1851
AUTHORIZED SIGNATORY
(PRINT NAME CLEARLY NEAR SIGNATURE)

AUTHORIZED SIGNATORY
(PRINT NAME CLEARLY NEAR SIGNATURE)

DAISEN GEE-WING
WITNESS AS TO BOTH SIGNATURES
(PRINT NAME CLEARLY NEAR SIGNATURE)

1200 - 777 WEST BROADWAY
ADDRESS

VICE PRESIDENT
OCCUPATION

AS TO OWNERS
MARCO POLO PROPERTIES LTD.
(INCORPORATION NO. 349405)

STEPHEN Y.W. LEUNG
AUTHORIZED SIGNATORY
(PRINT NAME CLEARLY NEAR SIGNATURE)

AUTHORIZED SIGNATORY
(PRINT NAME CLEARLY NEAR SIGNATURE)

DAISEN GEE-WING
WITNESS AS TO BOTH SIGNATURES
(PRINT NAME CLEARLY NEAR SIGNATURE)

1200 - 777 WEST BROADWAY
ADDRESS

VICE PRESIDENT
OCCUPATION

I, RAYMOND HAROLD JANZEN, OF DELTA, BRITISH COLUMBIA LAND SURVEYOR, HEREBY CERTIFY THAT THE BUILDINGS SHOWN ON THIS STRATA PLAN HAVE NOT, AS OF THE 30 th DAY OF MARCH , 1994, BEEN PREVIOUSLY OCCUPIED .
DATED AT SURREY, B. C. , THIS 30 th DAY OF MARCH , 1994.

B. C. L. S.

FILE 7995

FILED LMLM51328 M70974 2004-02-17-14.01.34.050263

CONDOMINIUM ACT

STRATA PLAN LMS 1328
PHASE I

		FORM 1	FORM 2	FORM 3
STRATA LOT NUMBER	SHEET NUMBER	SCHEDULE OF UNIT ENTITLEMENT	SCHEDULE OF INTEREST UPON DESTRUCTION	SCHEDULE OF VOTING RIGHTS
1	6	605	38452	1
2	6	605	38515	1
3	6	607	38286	1
4	6	646	40307	1
5	6	758	43338	1
6	6	605	37480	1
7	6	605	37455	1
8	6	605	37455	1
9	6	686	40451	1
10	6	748	42060	1
11	6	616	38775	1
12	6	513	34502	1
13	6	492	33688	1
14	6	605	37994	1
15	6	605	38047	1
16	7	686	40131	1
17	7	605	38663	1
18	7	605	38663	1
19	7	607	37846	1
20	7	646	39965	1
21	7	758	41458	1
22	7	605	37776	1

		FORM 1	FORM 2	FORM 3
STRATA LOT NUMBER	SHEET NUMBER	SCHEDULE OF UNIT ENTITLEMENT	SCHEDULE OF INTEREST UPON DESTRUCTION	SCHEDULE OF VOTING RIGHTS
23	7	605	37973	1
24	7	605	37973	1
25	7	686	40131	1
26	7	748	43310	1
27	7	616	38761	1
28	7	745	44028	1
29	7	670	41261	1
30	7	605	38501	1
31	7	605	38501	1
32	7	686	40131	1
33	8	686	40494	1
34	8	605	39025	1
35	8	605	39025	1
36	8	607	38209	1
37	8	646	40328	1
38	8	758	41821	1
39	8	605	38138	1
40	8	605	38335	1
41	8	605	38335	1
42	8	686	40494	1
43	8	748	43321	1
44	8	616	39124	1

		FORM 1	FORM 2	FORM 3
STRATA LOT NUMBER	SHEET NUMBER	SCHEDULE OF UNIT ENTITLEMENT	SCHEDULE OF INTEREST UPON DESTRUCTION	SCHEDULE OF VOTING RIGHTS
45	8	745	44391	1
46	8	670	41624	1
47	8	605	38863	1
48	8	605	38863	1
49	8	686	40494	1
50	9	686	41036	1
51	9	605	38754	1
52	9	605	38754	1
53	9	607	38754	1
54	9	646	42983	1
55	9	758	42388	1
56	9	605	38680	1
57	9	605	38881	1
58	9	605	38881	1
59	9	686	41036	1
60	9	748	43831	1
61	9	616	39685	1
62	9	745	44732	1
63	9	670	41979	1
64	9	605	38663	1
65	9	605	38663	1
66	9	686	41036	1
AGGREGATE		42 550.	2621456 / 9 000 000	66

MURRAY & ASSOCIATES
201-12448 82nd AVENUE
SURREY, B.C.
V3W 3E9
(604) 597-9189

MARCH 25, 1994

FILE 7995

FILED LMLMS1328 M70974 2004-02-17-14.01.34.850263

BUILDING SECTIONS

STRATA PLAN LMS 1328
PHASE I

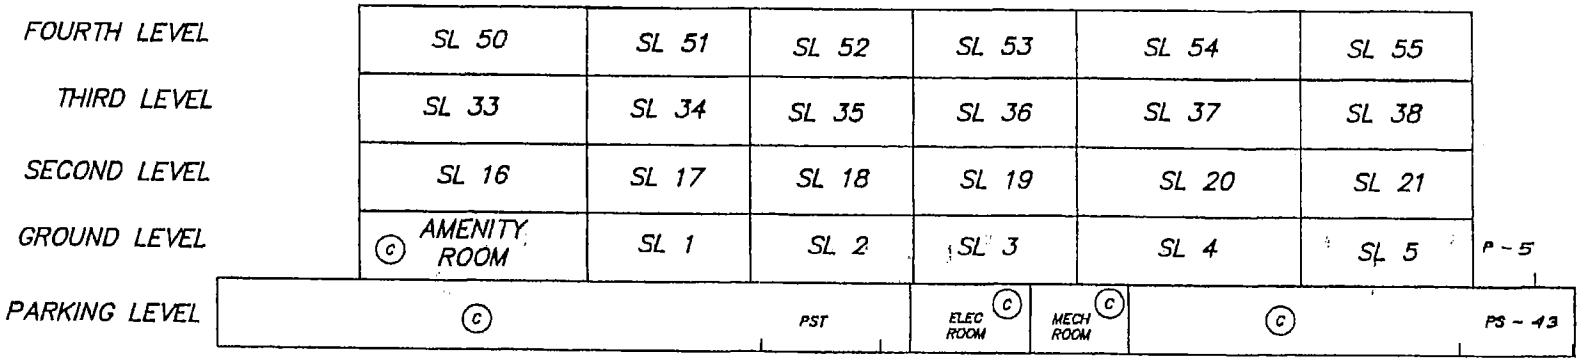

SECTION A - A'

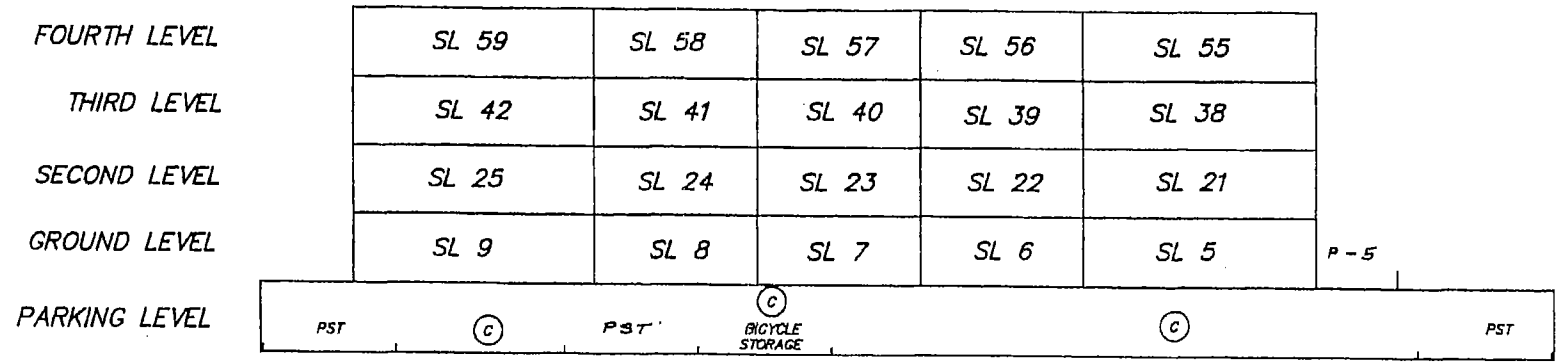

SECTION B - B'

NOT TO SCALE

MURRAY & ASSOCIATES
201-12448 82nd AVENUE
SURREY, B.C.
V3W 3E9
(604) 597-9189

RJF
MARCH 29, 1994

FILE 7995

FILED LMLMS1328 M70974 2004-02-17-14.01.34.050263

SHEET 5 OF 11 SHEETS

PARKING LEVEL

STRATA PLAN LMS 1328
PHASE I

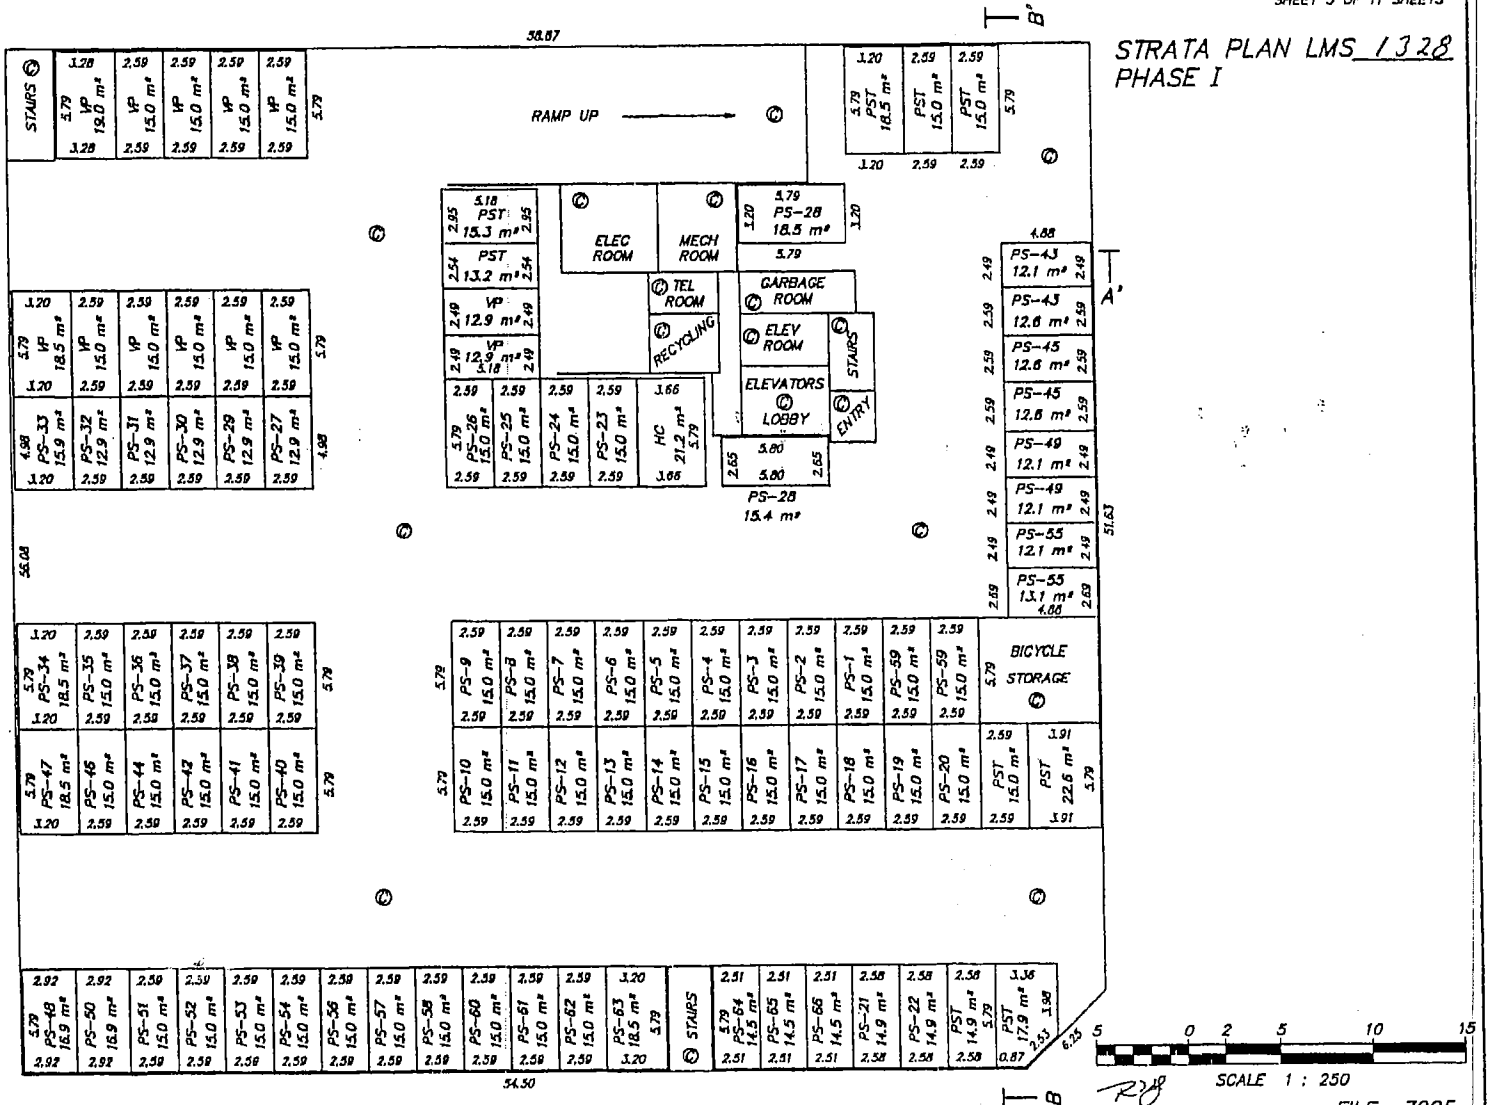

MURRAY & ASSOCIATES
201–12448 82nd AVENUE
SURREY, B.C.
V3W 3E9
(604) 597–9189

MARCH 29, 1994

FILE 7995

FILED LMLM91328 M70974 2004-02-17-14.01.34.050263

SHEET 6 OF 11 SHEETS

GROUND LEVEL

STRATA PLAN LMS 1328
PHASE I

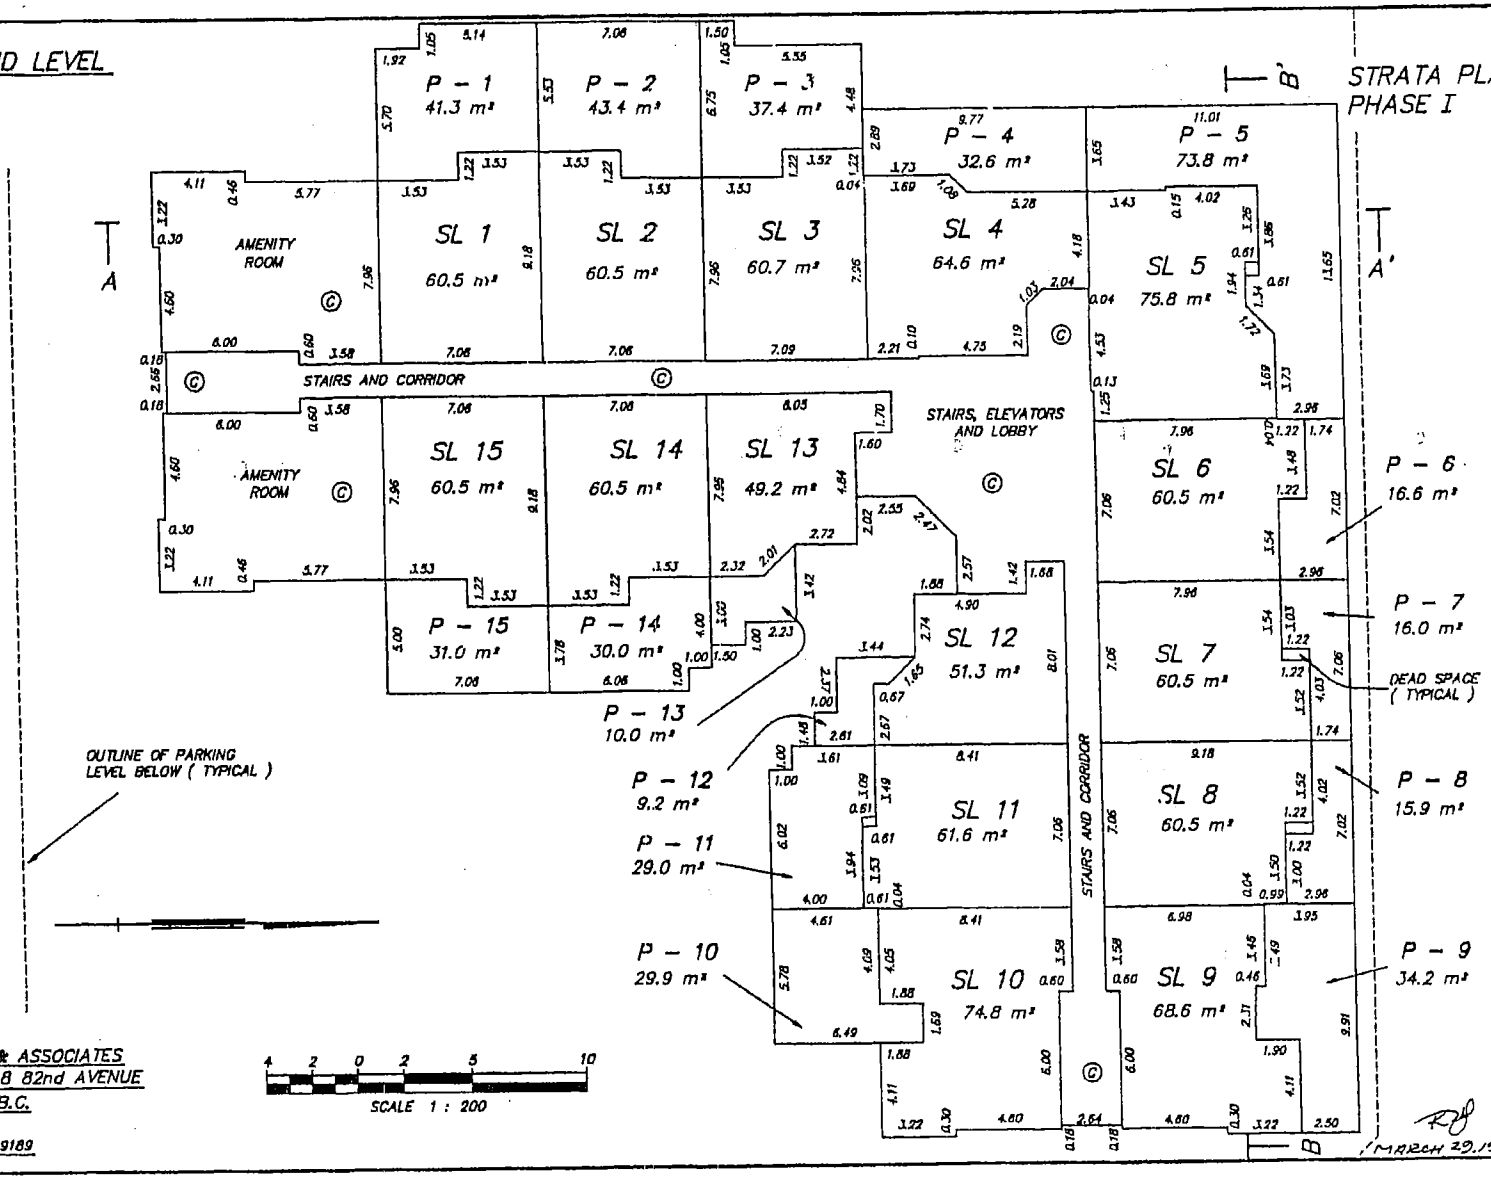

MURRAY & ASSOCIATES
201-12448 82nd AVENUE
SURREY, B.C.
V3W 3E9
(604) 597-9189

4 2 0 2 5 10
SCALE 1 : 200

MARCH 29, 1994 FILE 7995

FILED LMLM31328 M70974 2004-02-17-14.01.34.850263

SECOND LEVEL

STRATA PLAN LMS 1328
PHASE I

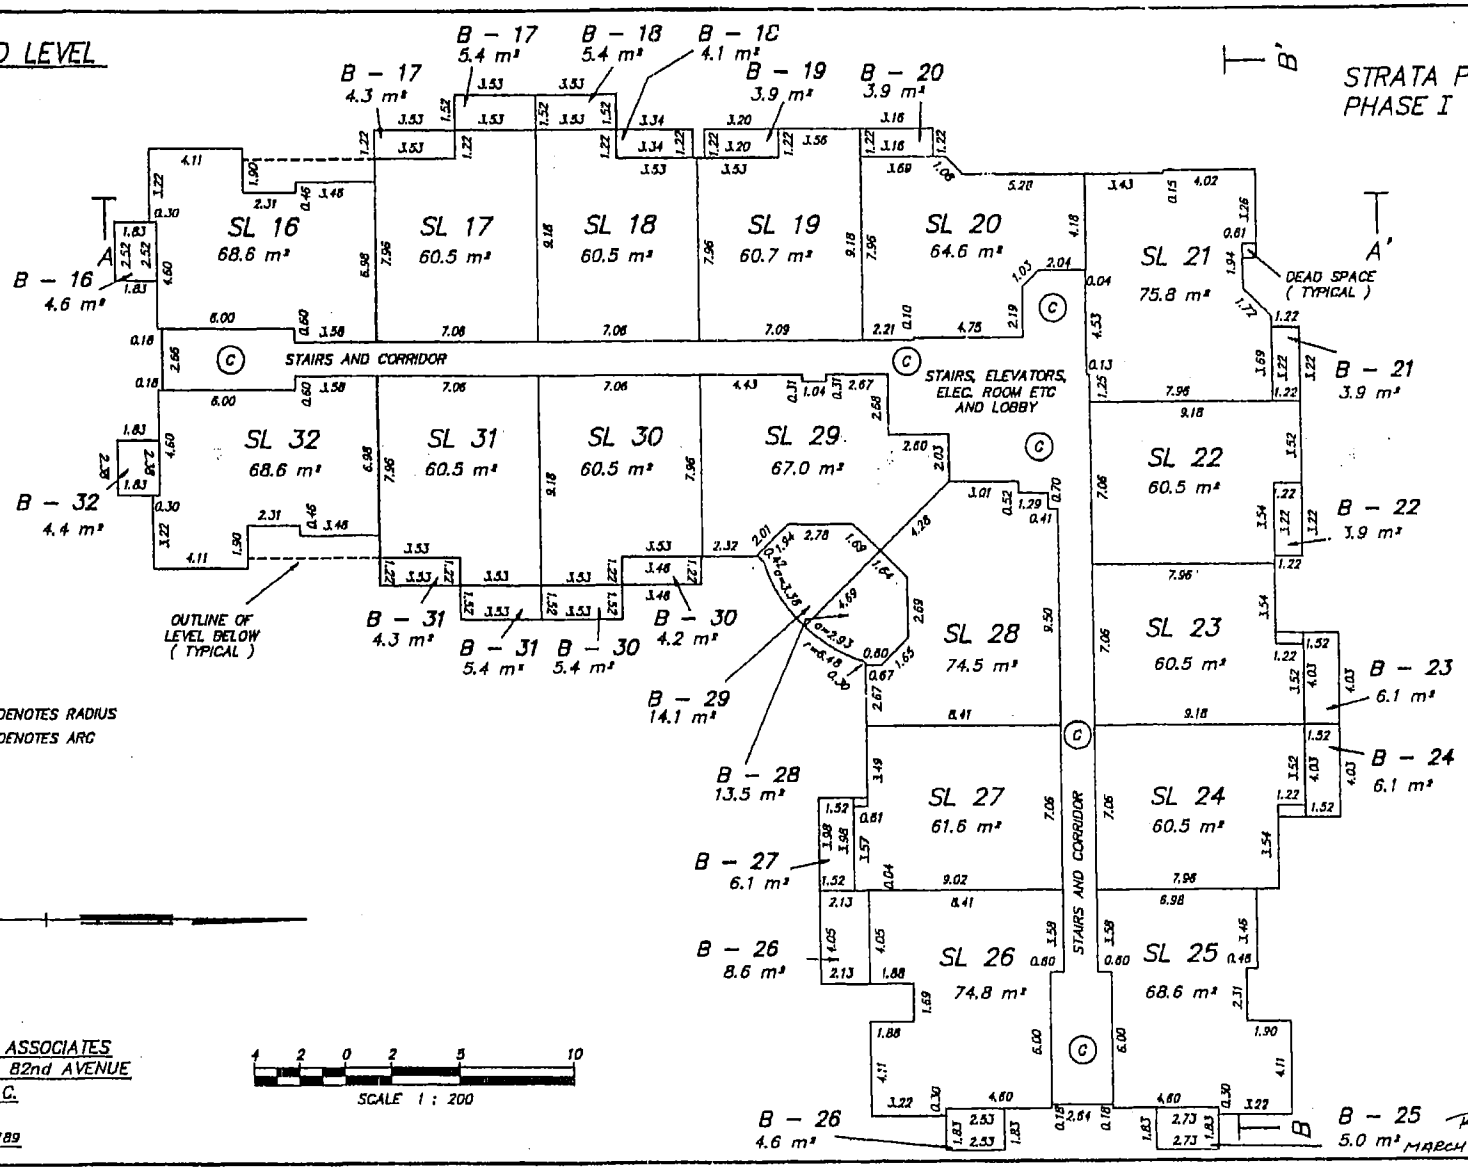

MURRAY & ASSOCIATES
201–12448 82nd AVENUE
SURREY, B.C.
V3W 3E9
(604) 597–9189

MARCH 29, 1994 FILE 7995

FILED LMLMS1320 M70974 2004-02-17-14.01.34.050263

THIRD LEVEL

STRATA PLAN LMS 1328
PHASE I

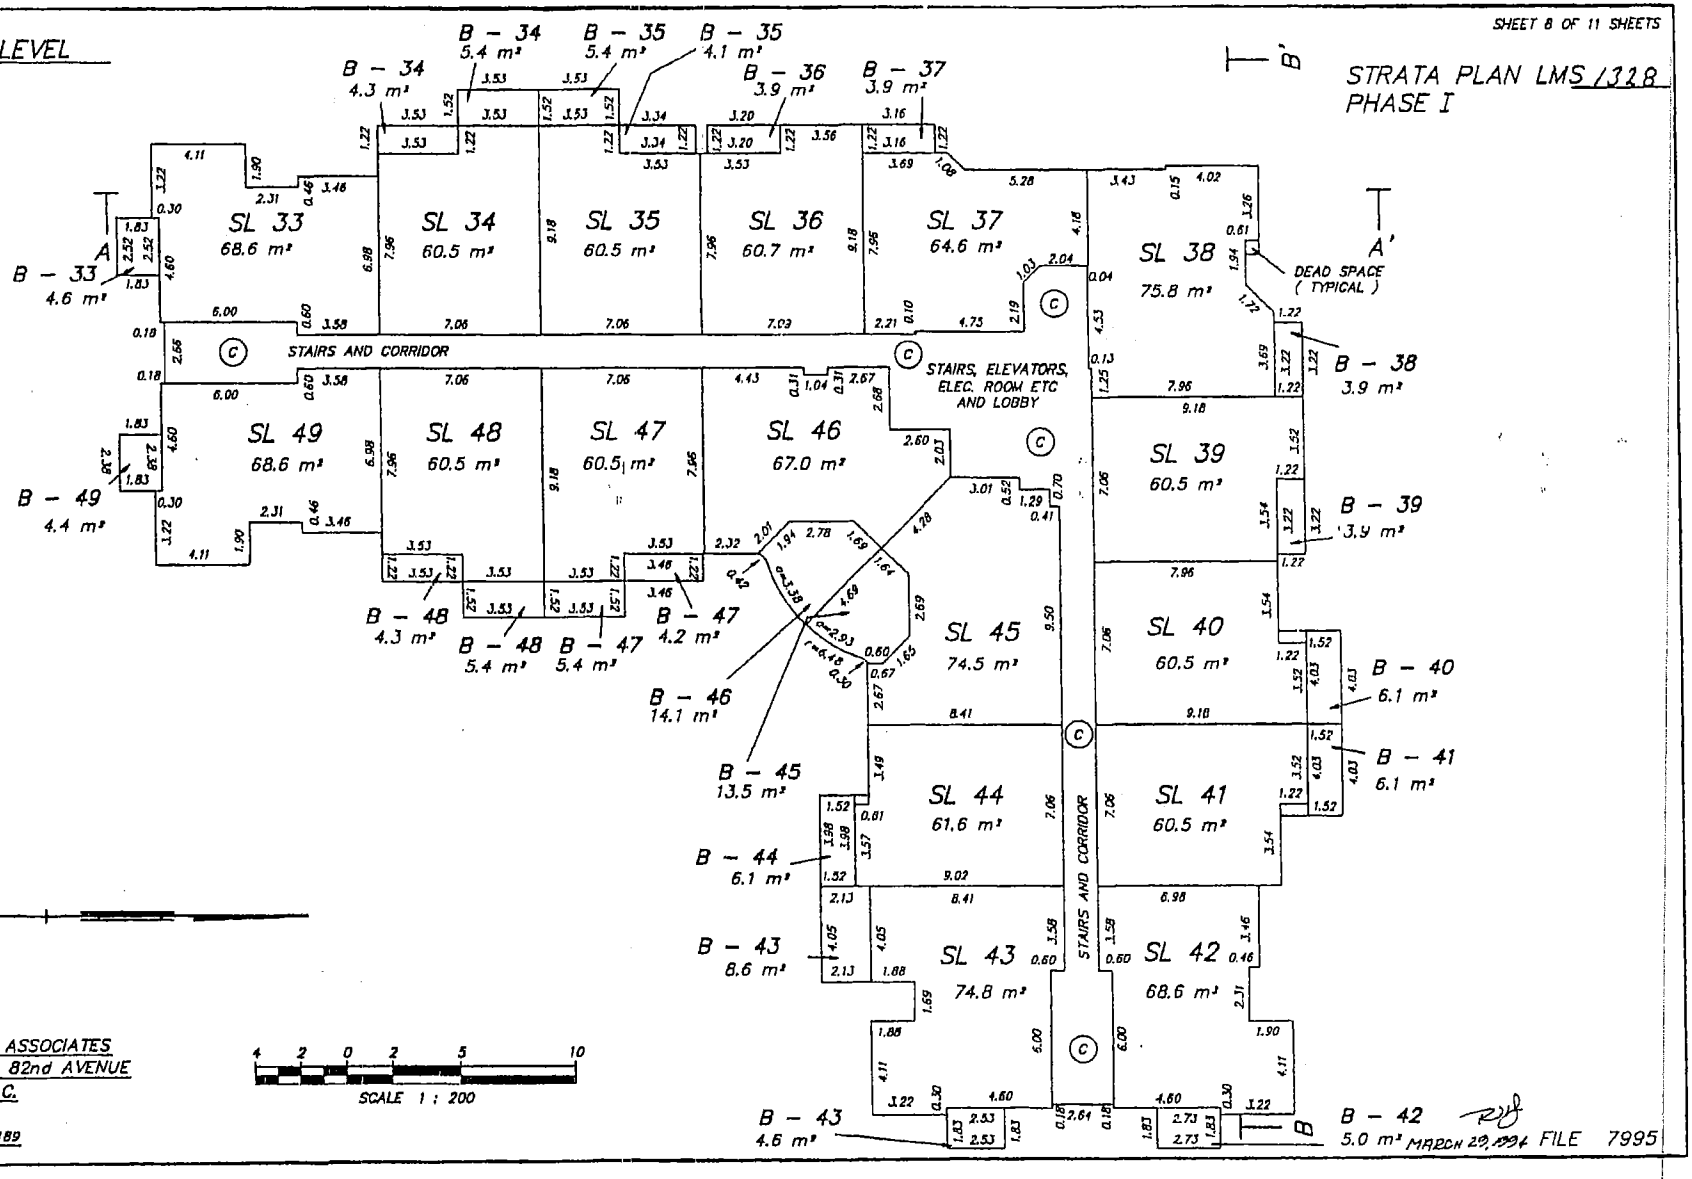

MURRAY & ASSOCIATES
201–12448 82nd AVENUE
SURREY, B.C.
V3W 3E9
(604) 597–9189

SCALE 1 : 200

MARCH 29, 1994 FILE 7995

FILED LMLM91328 M70974 2004-02-17-14.01.34.050263

SHEET 9 OF 11 SHEETS

FOURTH LEVEL

STRATA PLAN LMS /328
PHASE I

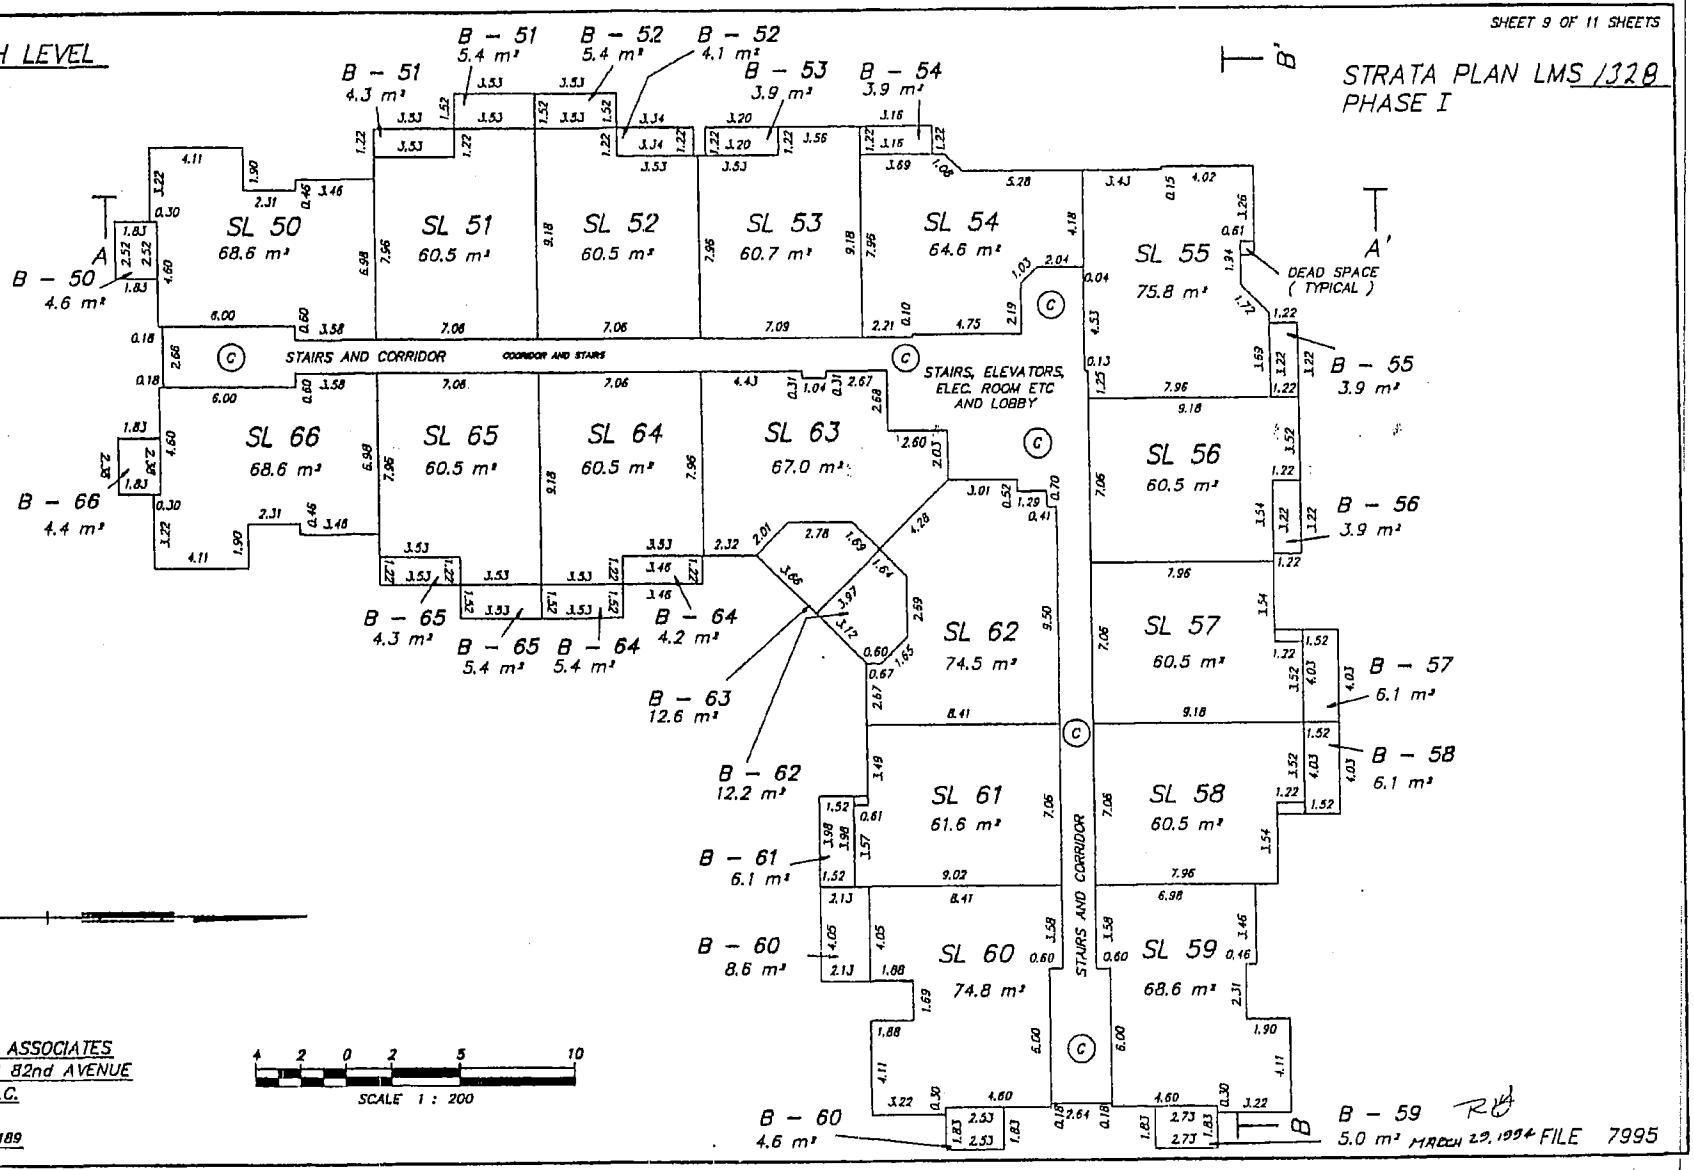

MURRAY & ASSOCIATES
201–12448 82nd AVENUE
SURREY, B.C.
V3W 3E9
(604) 597-9189

SCALE 1 : 200

MARCH 29, 1994 FILE 7995

FILED LMLM91328 M70974 2004-02-17-14.01.34.850263

STRATA PLAN LMS 1328

RECORD OF BY-LAWS AND ORDERS, ETC.

FILING		DOCUMENT		FILING		DOCUMENT	
NUMBER	DATE	DATE	NATURE OF PARTICULARS	NUMBER	DATE	DATE	NATURE OF PARTICULARS
BK51601	23-2-96		NOTIFICATION OF CHANGE OF BYLAWS				
BL96305	Mar. 19/97		Notification of change of Bylaws.				
BM47885	16-02-96		Change of Bylaws				

RDF MARCH 29, 1994

FILE 7995

FILED LMLMS1320 M70974 2004-02-17-14.01.34.050263

mmon Property Sheet Closed 3/1/96

Search ALTOS2 or BC OnLine for Current Information, BC Reg. 76/95

LINDA J. O'BRIEN, Registrar
Vancouver/New Westminster Land Title District

STRATA PLAN LMS 1328

DEALINGS AFFECTING THE COMMON PROPERTY

REGISTRATION		DOCUMENT		REGISTRATION		DOCUMENT	
NUMBER	DATE	DATE	NATURE OF PARTICULARS	NUMBER	DATE	DATE	NATURE OF PARTICULARS
THIS TITLE MAY BE AFFECTED BY A PERMIT UNDER PART 29 OF THE MUNICIPAL ACT. SEE DF 407717.							
DF 363956	25.09.1992		COVENANT THE CORPORATION OF THE DISTRICT OF SURREY L.T.A. SECTION 215 INTER ALIA				
DF 426707	03.11.1992		COVENANT DISTRICT OF SURREY L.T.A. SECTION 215 INTER ALIA				
BJ 172975	13/06/1995		SPECIAL RESOLUTION GRANTING EXCLUSIVE USE PURSUANT TO SECTION 53 CONDOMINIUM ACT				

MARCH 29, 1994

FILE 7995

FILED LMLMS1328 M70974 2004-02-17-14.01.34.050263

FIRST SHEET SHEET 1 OF 24 SHEETS

STRATA PLAN OF LOT 1, PLAN LMP 8371, EXCEPT FIRSTLY : PHASE ONE STRATA PLAN LMS 1328, SECTION 22, BLOCK 5 NORTH, RANGE 2 WEST, NEW WESTMINSTER DISTRICT.

B.C.G.S. 92G . 016

0 5 10 20 30 40 50
SCALE 1 : 750

CIVIC ADDRESS :-
WHALLEY POINTE I
(GRANDVIEW COURT)
10523 - 134 th STREET
SURREY B.C.

THE ADDRESS FOR SERVICE OF DOCUMENTS ON THE STRATA TITLE IS :-
THE OWNERS
C/O THE OWNERS, STRATA PLAN LMS 1328
212 - 475 MAIN STREET,
VANCOUVER B.C.
V6A 4A4

INTEGRATED SURVEY AREA No. 1 - SURVEY

BEARINGS ARE GRID BEARINGS DERIVED FROM PLAN LMP 8371
THIS PLAN SHOWS GROUND LEVEL MEASURED DISTANCES. PRIOR TO COMPUTATION OF U.T.M. CO-ORDINATES, MULTIPLY BY COMBINED FACTOR 0.9995969509

LOCATION PLAN AND DIMENSIONS

FOR DIMENSIONS REFER TO FLOOR PLAN SHEETS

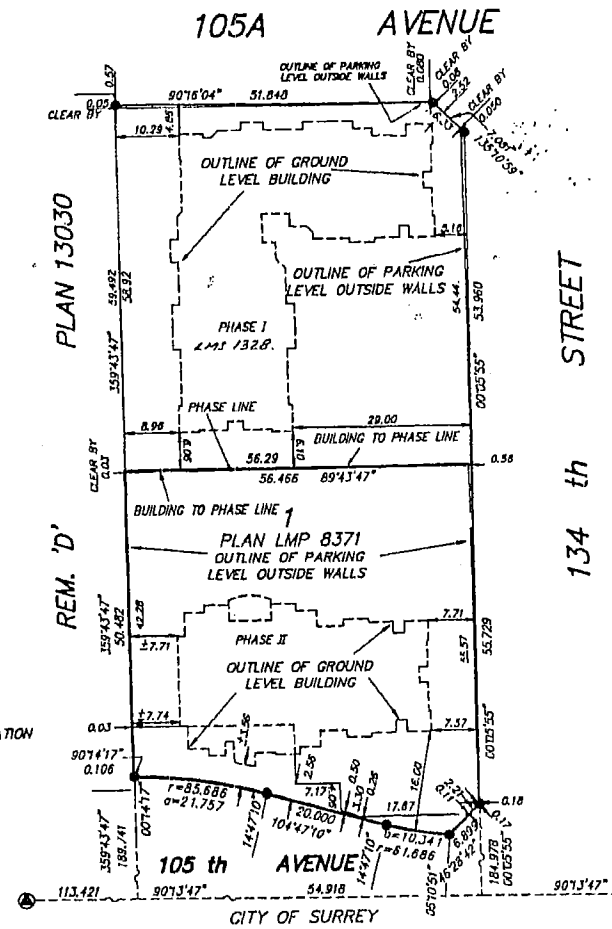

THIS PLAN LIES WITHIN THE GREATER VANCOUVER REGIONAL DISTRICT

STRATA PLAN LMS 1328
PHASE II

BH 396 443

DEPOSITED AND REGISTERED IN THE LAND TITLE OFFICE AT NEW WESTMINSTER BRITISH COLUMBIA, DATED THIS 23 DAY OF SEPT 1994.

ASSIST'T DEPUTY REGISTRAR

▲	DENOTES CONTROL MONUMENT FOUND
●	DENOTES STANDARD IRON POST FOUND
R	DENOTES RADIUS
L	DENOTES ARC LENGTH
SL	DENOTES STRATA LOT
m²	DENOTES SQUARE METRES
P	DENOTES PATIO AREA
B	DENOTES BALCONY
PS	DENOTES PARKING STALL (LIMITED COMMON PROPERTY)
PST	DENOTES PARKING STALL (COMMON PROPERTY)
VP	DENOTES VISITOR PARKING STALL (COMMON PROPERTY)
©	DENOTES COMMON PROPERTY
HC	DENOTES HANDICAP PARKING STALL (COMMON PROPERTY)

ALL DIMENSIONS ARE IN METRES
ALL ANGLES ARE 45 OR 90 DEGREES
UNLESS INDICATED OTHERWISE

AREAS INDICATED AS P, B OR PS ARE LIMITED COMMON PROPERTY APPURTENANT TO THE STRATA LOT INDICATED THUS : P - 70, B - 770 OR PS - 70

LIMITED COMMON PROPERTY IS NOT INCLUDED IN THE UNIT ENTITLEMENT.

I, H. DAVID LIDDLE, OF ALDERGROVE, BRITISH COLUMBIA LAND SURVEYOR, HEREBY CERTIFY THAT THE BUILDINGS ERECTED ON THE PARCEL DESCRIBED ABOVE ARE WHOLLY WITHIN THE EXTERNAL BOUNDARIES OF THAT PARCEL. DATED AT SURREY, B.C. THIS 25 th DAY OF AUGUST , 1994.

H. David Liddle B. C. L. S.

FILE 7995

MURRAY & ASSOCIATES
201-12448 82nd AVENUE
SURREY, B.C.
V3W 3E9
(604) 597-9189

FILED LML M91328 M70974 2004-02-17-14.01.34.050263

SECOND SHEET SHEET 2 OF 24 SHEETS

CONDOMINIUM ACT

STRATA PLAN LMS _____
PHASE II

STATUTORY DECLARATION

I/WE THE UNDERSIGNED DO SOLEMNLY DECLARE THAT :

1) I/WE THE UNDERSIGNED (AM/ARE) THE OWNER-DEVELOPER OR (IN THE ALTERNATIVE) THE DULY AUTHORIZED AGENT OF THE OWNER-DEVELOPER

2) THE STRATA PLAN IS ENTIRELY FOR RESIDENTIAL USE

I/WE MAKE THIS SOLEMN DECLARATION CONSCIENTIOUSLY BELIEVING IT TO BE TRUE AND KNOWING THAT IT IS OF THE SAME FORCE AND EFFECT AS IF MADE UNDER OATH

DECLARED BEFORE ME
AT VANCOUVER
IN THE PROVINCE OF B.C.
THIS 14 DAY OF SEPTEMBER
1994.

J. Gee-Wing DAISEN GEE-WING

A NOTARY PUBLIC IN AND FOR THE PROVINCE OF BRITISH COLUMBIA
A COMMISSIONER FOR TAKING AFFIDAVITS WITHIN BRITISH COLUMBIA
NORMAN CHOW

ACCEPTED AS TO FORMS 1, 2, AND 3.
DATED THIS 21 DAY OF Sept. 1994.

for: SUPERINTENDENT OF REAL ESTATE

APPROVED AS PHASE II OF A II PHASE STRATA PLAN UNDER THE CONDOMINIUM ACT.
DATED THIS 14th DAY OF September 1994

APPROVING OFFICER FOR THE
CITY OF SURREY

I HEREBY CERTIFY THAT THE COMMON FACILITIES, BEING : RECREATION FACILITIES
WHICH, ACCORDING TO FORM E TO THE ACT, WERE TO HAVE BEEN CONSTRUCTED IN CONJUNCTION WITH THIS PHASE, HAVE BEEN SATISFACTORILY PROVIDED FOR.
DATED THIS 14th DAY OF September 1994

APPROVING OFFICER FOR THE
CITY OF SURREY

MURRAY & ASSOCIATES
201-12448 82nd AVENUE
SURREY, B.C.
V3W 3E9
(604) 597-9189

AS TO MORTGAGE ANF ASSIGNMENT OF RENTS
HONGKONG BANK OF CANADA

BLONDEL SO
AUTHORIZED SIGNATORY
(PRINT NAME CLEARLY NEAR SIGNATURE) BLONDEL SO

ALBERT WONG
AUTHORIZED SIGNATORY
(PRINT NAME CLEARLY NEAR SIGNATURE) ALBERT WONG

J. Gee-Wing DAISEN GEE-WING
WITNESS AS TO BOTH SIGNATURES
(PRINT NAME CLEARLY NEAR SIGNATURE)

1200 - 777 WEST BROADWAY
ADDRESS

BUSINESSMAN
OCCUPATION

AS TO OWNERS
MARCO POLO PROPERTIES LTD.
(INCORPORATION NO. 349405)

J. Gee-Wing DAISEN GEE-WING
AUTHORIZED SIGNATORY
(PRINT NAME CLEARLY NEAR SIGNATURE)

AUTHORIZED SIGNATORY
(PRINT NAME CLEARLY NEAR SIGNATURE)

Bill Koo
WITNESS AS TO BOTH SIGNATURES
(PRINT NAME CLEARLY NEAR SIGNATURE)

10685, 156th Street, Surrey.
ADDRESS

ACCOUNTANT
OCCUPATION

I, H. DAVID LIDDLE, OF ALDERGROVE, BRITISH COLUMBIA LAND SURVEYOR, HEREBY CERTIFY THAT THE BUILDINGS SHOWN ON THIS STRATA PLAN HAVE NOT, AS OF THE 25 th DAY OF AUGUST , 1994, BEEN PREVIOUSLY OCCUPIED , DATED AT SURREY, B. C. , THIS 25 th DAY OF AUGUST , 1994.

H. David Liddle B. C. L. S.

FILE 7995

FILED LMLM91320 M70974 2004-02-17-14.01.34.850263

CONDOMINIUM ACT

STRATA PLAN LMS 1328
PHASE II

STRATA LOT NUMBER	SHEET NUMBER	FORM 1 SCHEDULE OF UNIT ENTITLEMENT	FORM 2 SCHEDULE OF INTEREST UPON DESTRUCTION	FORM 3 SCHEDULE OF VOTING RIGHTS
67	9	889	54886	1
68	9	614	40592	1
69	9	723	50238	1
70	9	723	49147	1
71	9	614	40064	1
72	9	875	54041	1
73	9	635	44958	1
74	10	663	47704	1
75	10	633	45204	1
76	10	890	54886	1
77	10	614	44394	1
78	10	723	40238	1
79	10	723	49147	1
80	10	614	45274	1
81	10	875	54041	1
82	10	633	44958	1
83	10	662	46260	1
84	10	629	45591	1
85	11	663	48126	1
86	11	633	45662	1
87	11	890	55343	1
88	11	614	44817	1
89	11	723	50661	1
90	11	723	49570	1
91	11	614	45697	1
92	11	875	54463	1
93	11	633	45415	1
94	11	662	46718	1
95	11	629	46014	1
96	12	663	48584	1
97	12	633	46084	1
98	12	890	55766	1
99	12	614	45239	1
100	12	723	51083	1
101	12	723	49992	1
102	12	614	46155	1
103	12	875	54886	1
104	12	633	45838	1
105	12	662	47140	1
106	12	629	46436	1
107	13	663	49006	1
108	13	615	45697	1
109	13	662	52034	1
110	13	610	51647	1
111	13	645	51259	1
112	13	621	45943	1
113	13	662	48478	1
114	13	613	45310	1
115	14	663	49781	1
116	14	615	46507	1
117	14	662	49429	1
118	14	610	45732	1
119	14	645	48549	1
120	14	621	46401	1
121	14	662	48901	1
122	14	613	45732	1
123	15	663	49886	1
124	15	615	46577	1
125	15	662	49886	1
126	15	610	46190	1
127	15	645	48971	1
128	15	621	46823	1
129	15	662	49358	1
130	15	613	46190	1
131	16	663	51048	1
132	16	615	47739	1
133	16	662	51048	1
134	16	610	47316	1
135	16	645	50133	1
136	16	621	47985	1
137	16	662	50520	1
138	16	613	47316	1
139	17	663	51471	1
140	17	615	48161	1

MURRAY & ASSOCIATES
201-12448 82nd AVENUE
SURREY, B.C.
V3W 3E9
(604) 597-9189

A-S 25/94 1102 FILE 7995

FILED LMLMS1328 M70974 2004-02-17-14.01.34.050263

CONDOMINIUM ACT

STRATA PLAN LMS 1328
PHASE II

STRATA LOT NUMBER	SHEET NUMBER	FORM 1 SCHEDULE OF UNIT ENTITLEMENT	FORM 2 SCHEDULE OF INTEREST UPON DESTRUCTION	FORM 3 SCHEDULE OF VOTING RIGHTS
141	17	662	51471	1
142	17	610	47774	1
143	17	645	50555	1
144	17	621	48408	1
145	17	662	50943	1
146	17	613	47774	1
147	18	663	50626	1
148	18	615	48619	1
149	18	662	50626	1
150	18	610	48197	1
151	18	645	49816	1
152	18	621	48865	1
153	18	662	50098	1
154	18	613	48197	1
155	19	663	51083	1
156	19	615	49041	1
157	19	662	51083	1
158	19	610	48654	1
159	19	645	50238	1
160	19	621	49288	1
161	19	662	50555	1
162	19	613	48654	1
163	20	663	51506	1
164	20	615	49464	1
165	20	662	51506	1

STRATA LOT NUMBER	SHEET NUMBER	FORM 1 SCHEDULE OF UNIT ENTITLEMENT	FORM 2 SCHEDULE OF INTEREST UPON DESTRUCTION	FORM 3 SCHEDULE OF VOTING RIGHTS
166	20	610	49077	1
167	20	645	50696	1
168	20	621	49710	1
169	20	662	50978	1
170	20	613	49077	1
171	21	663	51964	1
172	21	615	49922	1
173	21	662	51964	1
174	21	610	49499	1
175	21	645	51119	1
176	21	621	50168	1
177	21	662	51400	1
178	21	613	49499	1
179	22	681	55935	1
180	22	680	55935	1
181	22	610	49957	1
182	22	657	55202	1
183	22	658	55202	1
184	22	613	49957	1
185	23	681	53337	1
186	23	680	53337	1
187	23	610	50379	1
188	23	657	52421	1
189	23	658	52421	1
190	23	613	50379	1

STRATA LOT NUMBER	SHEET NUMBER	FORM 1 SCHEDULE OF UNIT ENTITLEMENT	FORM 2 SCHEDULE OF INTEREST UPON DESTRUCTION	FORM 3 SCHEDULE OF VOTING RIGHTS
191	24	918	66961	1
192	24	902	67172	1
193	24	917	67876	1
194	24	862	65623	1
AGGREGATE PHASE II		85 266	6 378 544	128
PHASE I		42 550	2 621 456	66
TOTAL PHASE I AND II		127 816	9 000 000	194

MURRAY & ASSOCIATES
201–12448 82nd AVENUE
SURREY, B.C.
V3W 3E9
(604) 597–9189

Aug 25/94 NDP FILE 7995

FILED LMLMS1328 M70974 2004-02-17-14.01.34.050263

BUILDING SECTIONS

NOT TO SCALE

STRATA PLAN LMS 1328
PHASE II

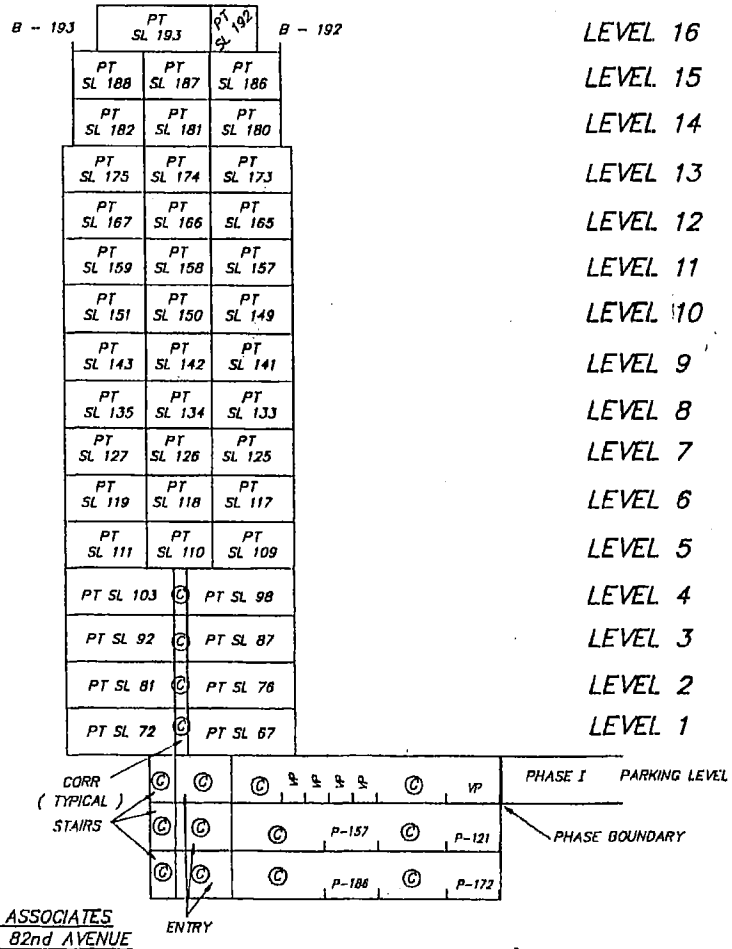

LEVEL 16
LEVEL 15
LEVEL 14
LEVEL 13
LEVEL 12
LEVEL 11
LEVEL 10
LEVEL 9
LEVEL 8
LEVEL 7
LEVEL 6
LEVEL 5
LEVEL 4
LEVEL 3
LEVEL 2
LEVEL 1

UPPER PARKING
MIDDLE PARKING
BOTTOM PARKING

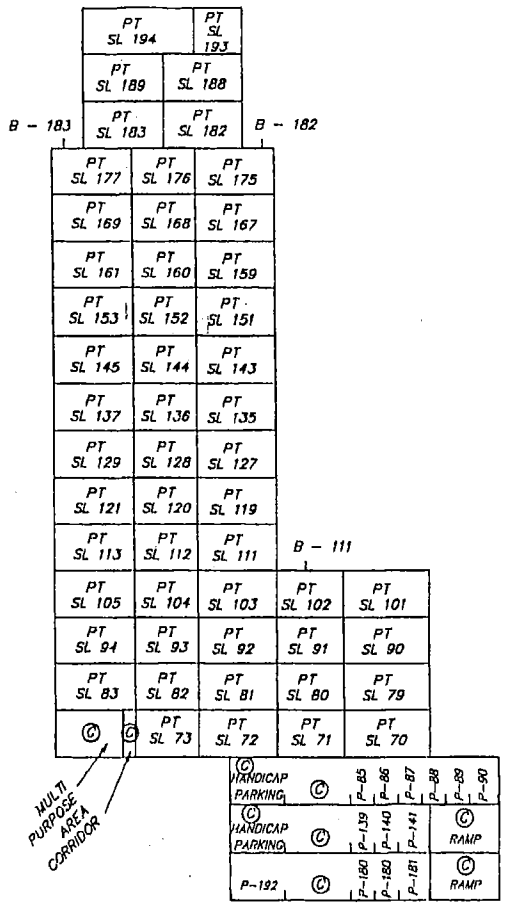

SECTION A – A'

SECTION B – B'

MURRAY & ASSOCIATES
201–12448 82nd AVENUE
SURREY, B.C.
V3W 3E9
(604) 597–9189

Aug 25/04 FILE 7995

FILED LMLM91328 M70974 2004-02-17-14.01.34.850263

BOTTOM PARKING LEVEL

STRATA PLAN LMS 1328
PHASE II

5 0 2 5 10 15
SCALE 1 : 250

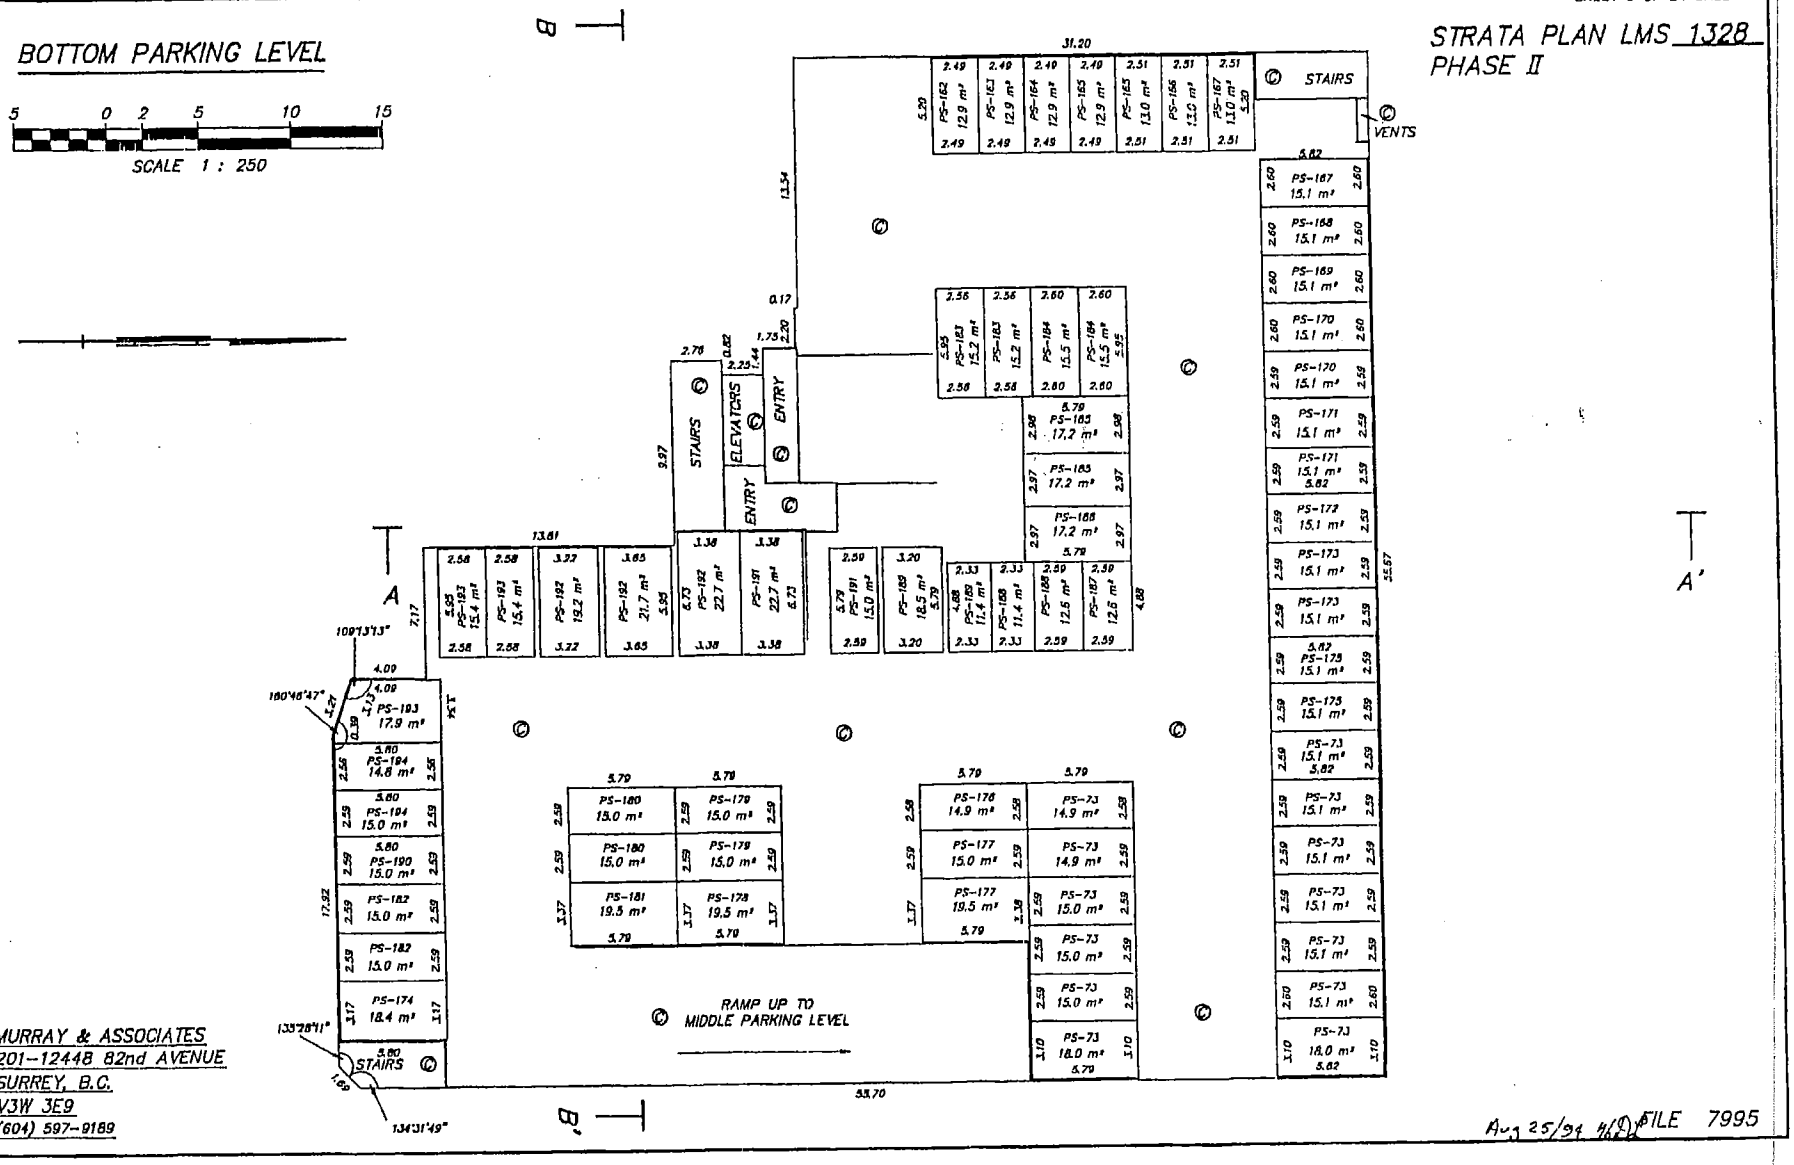

MURRAY & ASSOCIATES
201–12448 82nd AVENUE
SURREY, B.C.
V3W 3E9
(604) 597–9189

Aug 25/94 FILE 7995

FILED LMLM91320 M70974 2004-02-17-14.01.34.050263

MIDDLE PARKING LEVEL

STRATA PLAN LMS 1328
PHASE II

5 0 2 5 10 15
SCALE 1 : 250

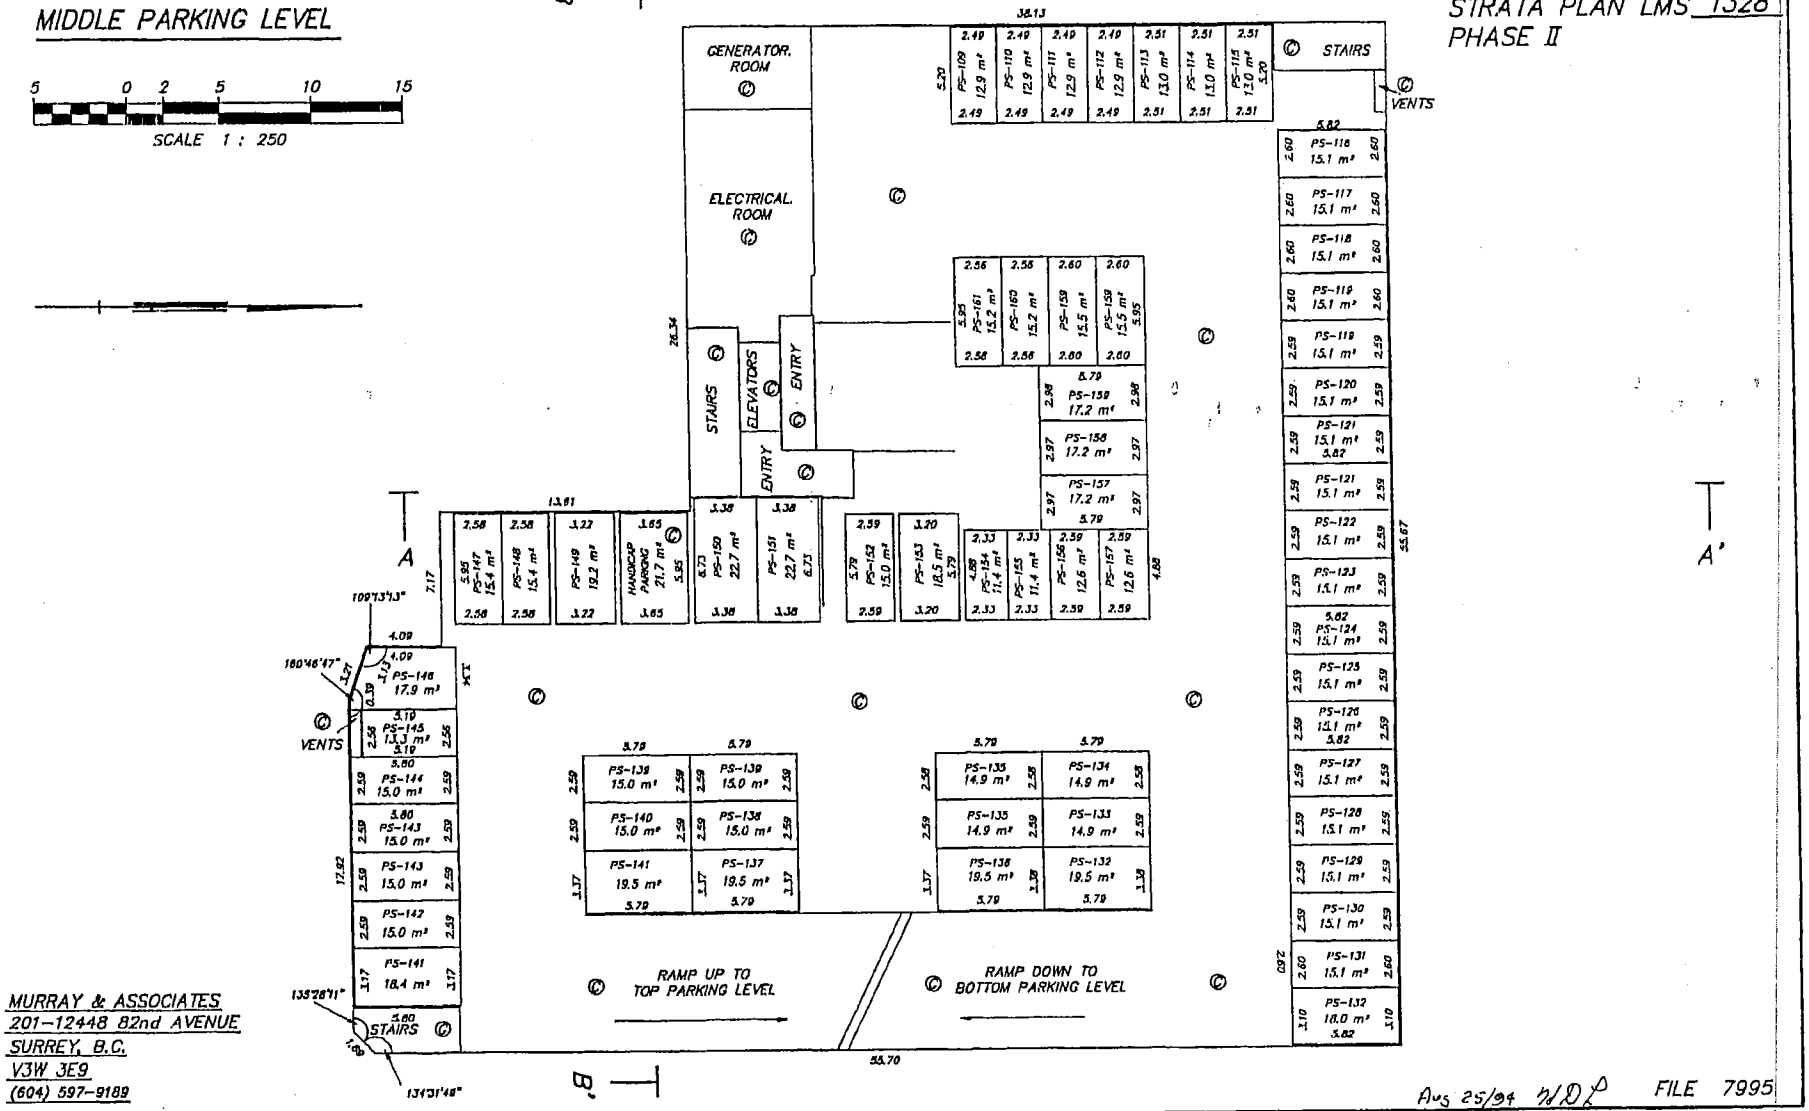

MURRAY & ASSOCIATES
201–12448 82nd AVENUE
SURREY, B.C.
V3W 3E9
(604) 597–9189

Aug 25/94 N/D.P FILE 7995

FILED LMLMS1328 M70974 2004-02-17-14.01.34.050263

TOP PARKING LEVEL

STRATA PLAN LMS 1328
PHASE II

5 0 2 5 10 15

SCALE 1 : 250

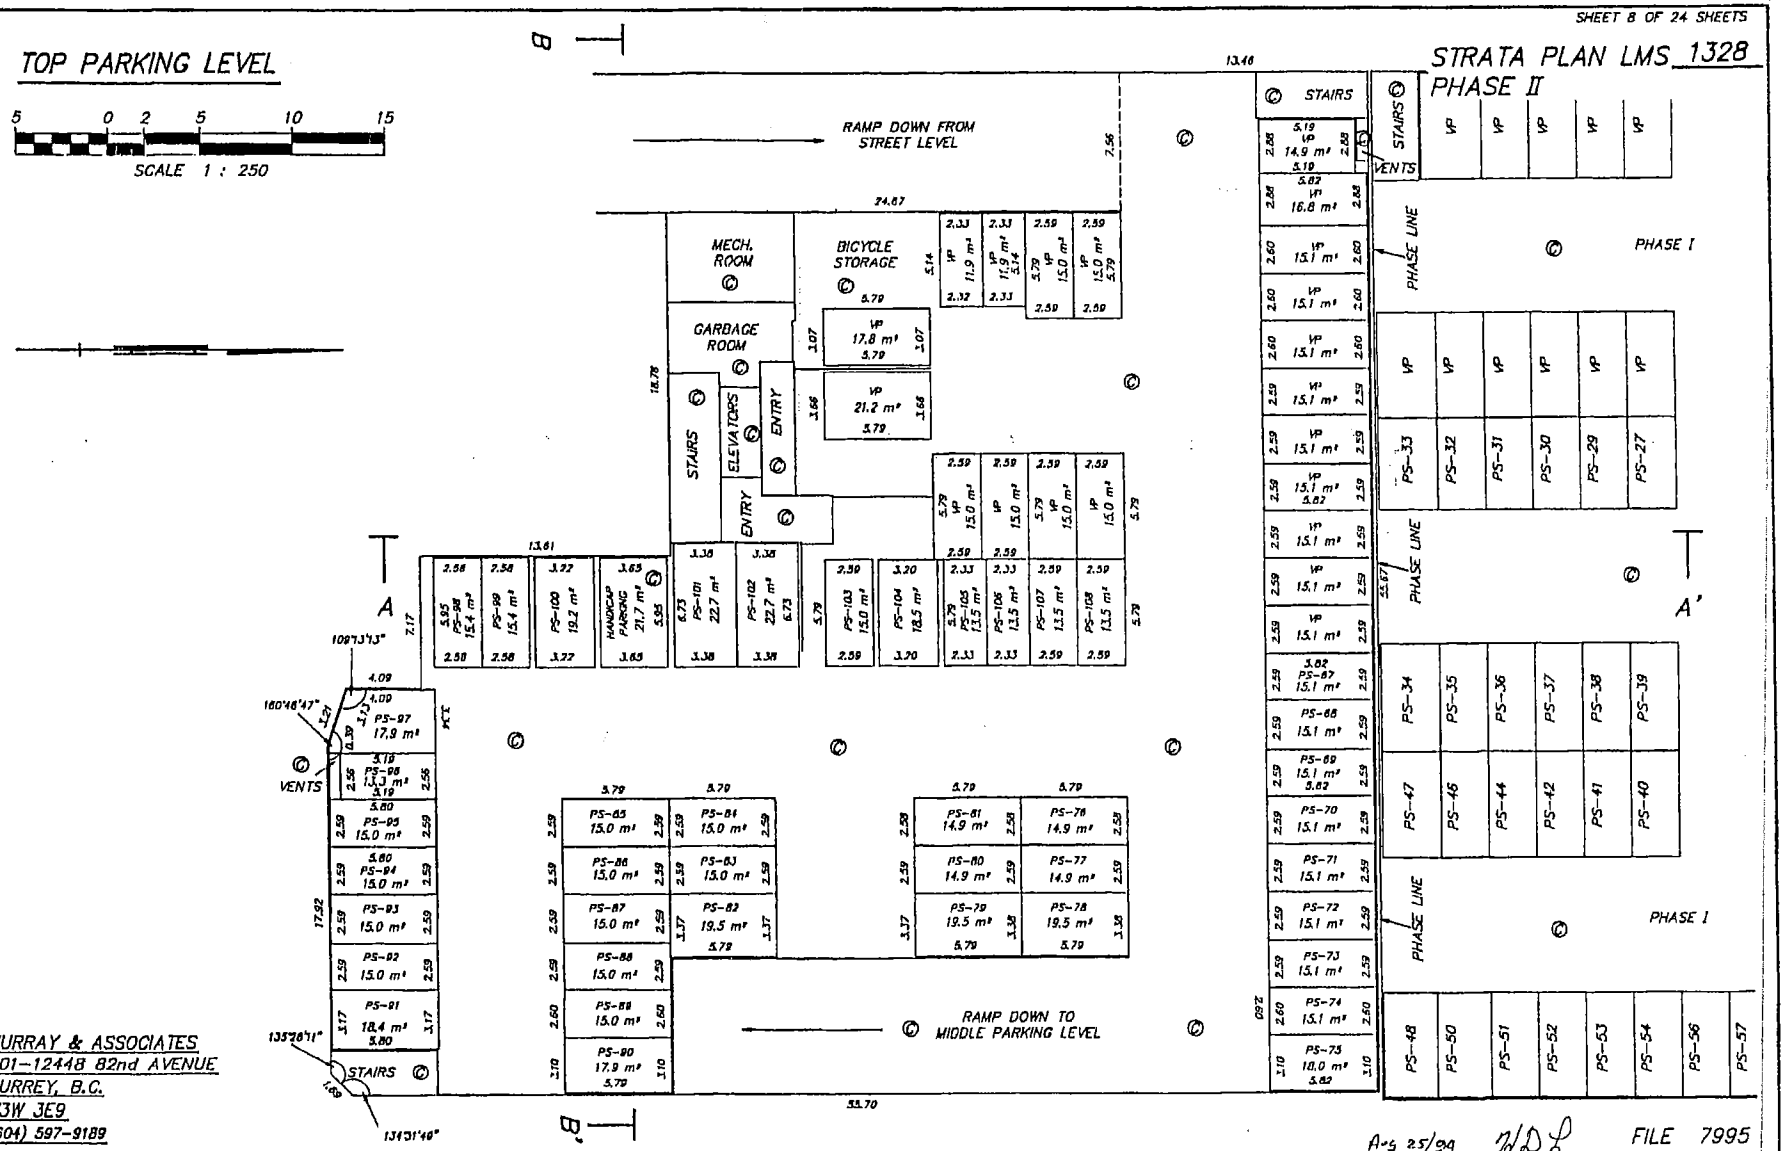

MURRAY & ASSOCIATES
201–12448 82nd AVENUE
SURREY, B.C.
V3W 3E9
(604) 597–9189

A-5 2.5/04 WDL FILE 7995

LEVEL 1

STRATA PLAN LMS 1328
PHASE II

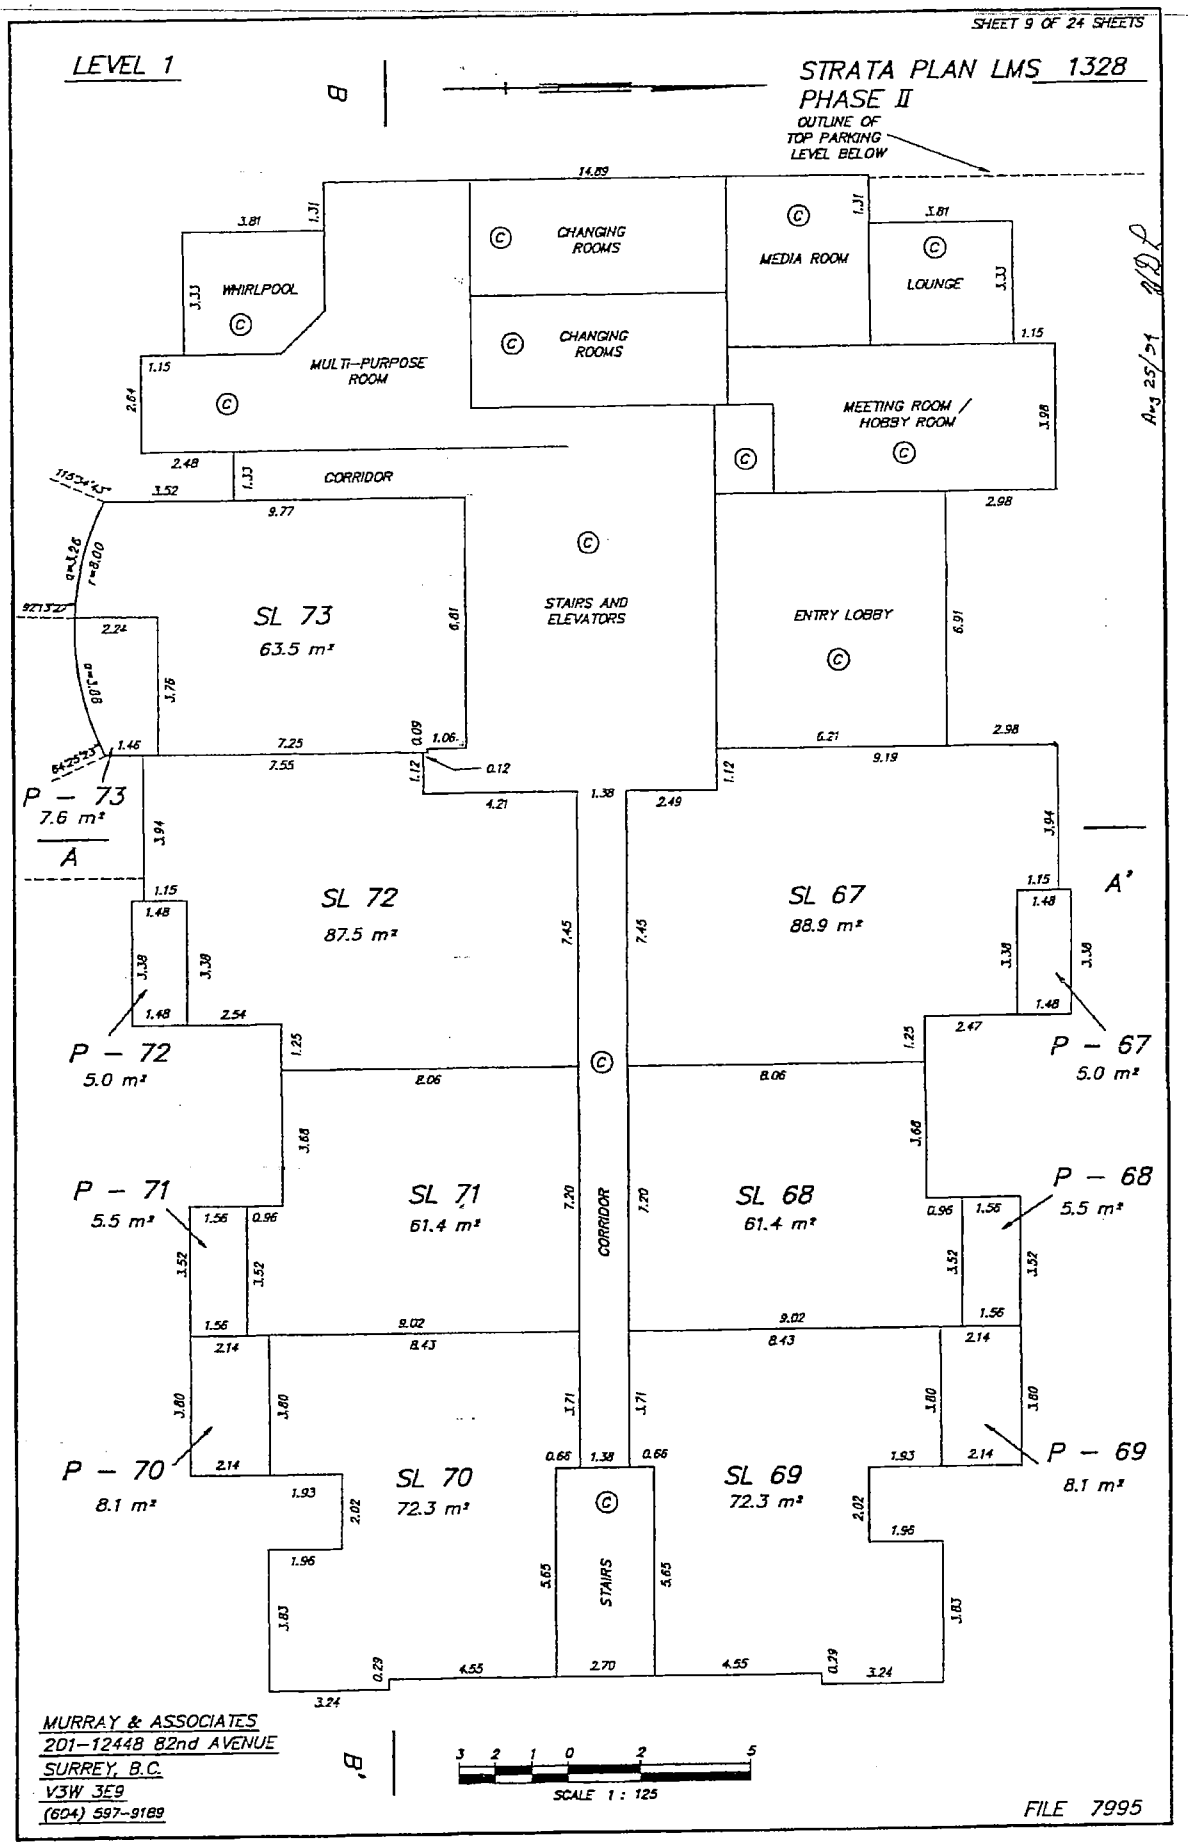

MURRAY & ASSOCIATES
201–12448 82nd AVENUE
SURREY, B.C.
V3W 3E9
(604) 597–9189

FILE 7995

FILED LMLM93128 M70974 2004-02-17-14.01.34.850263

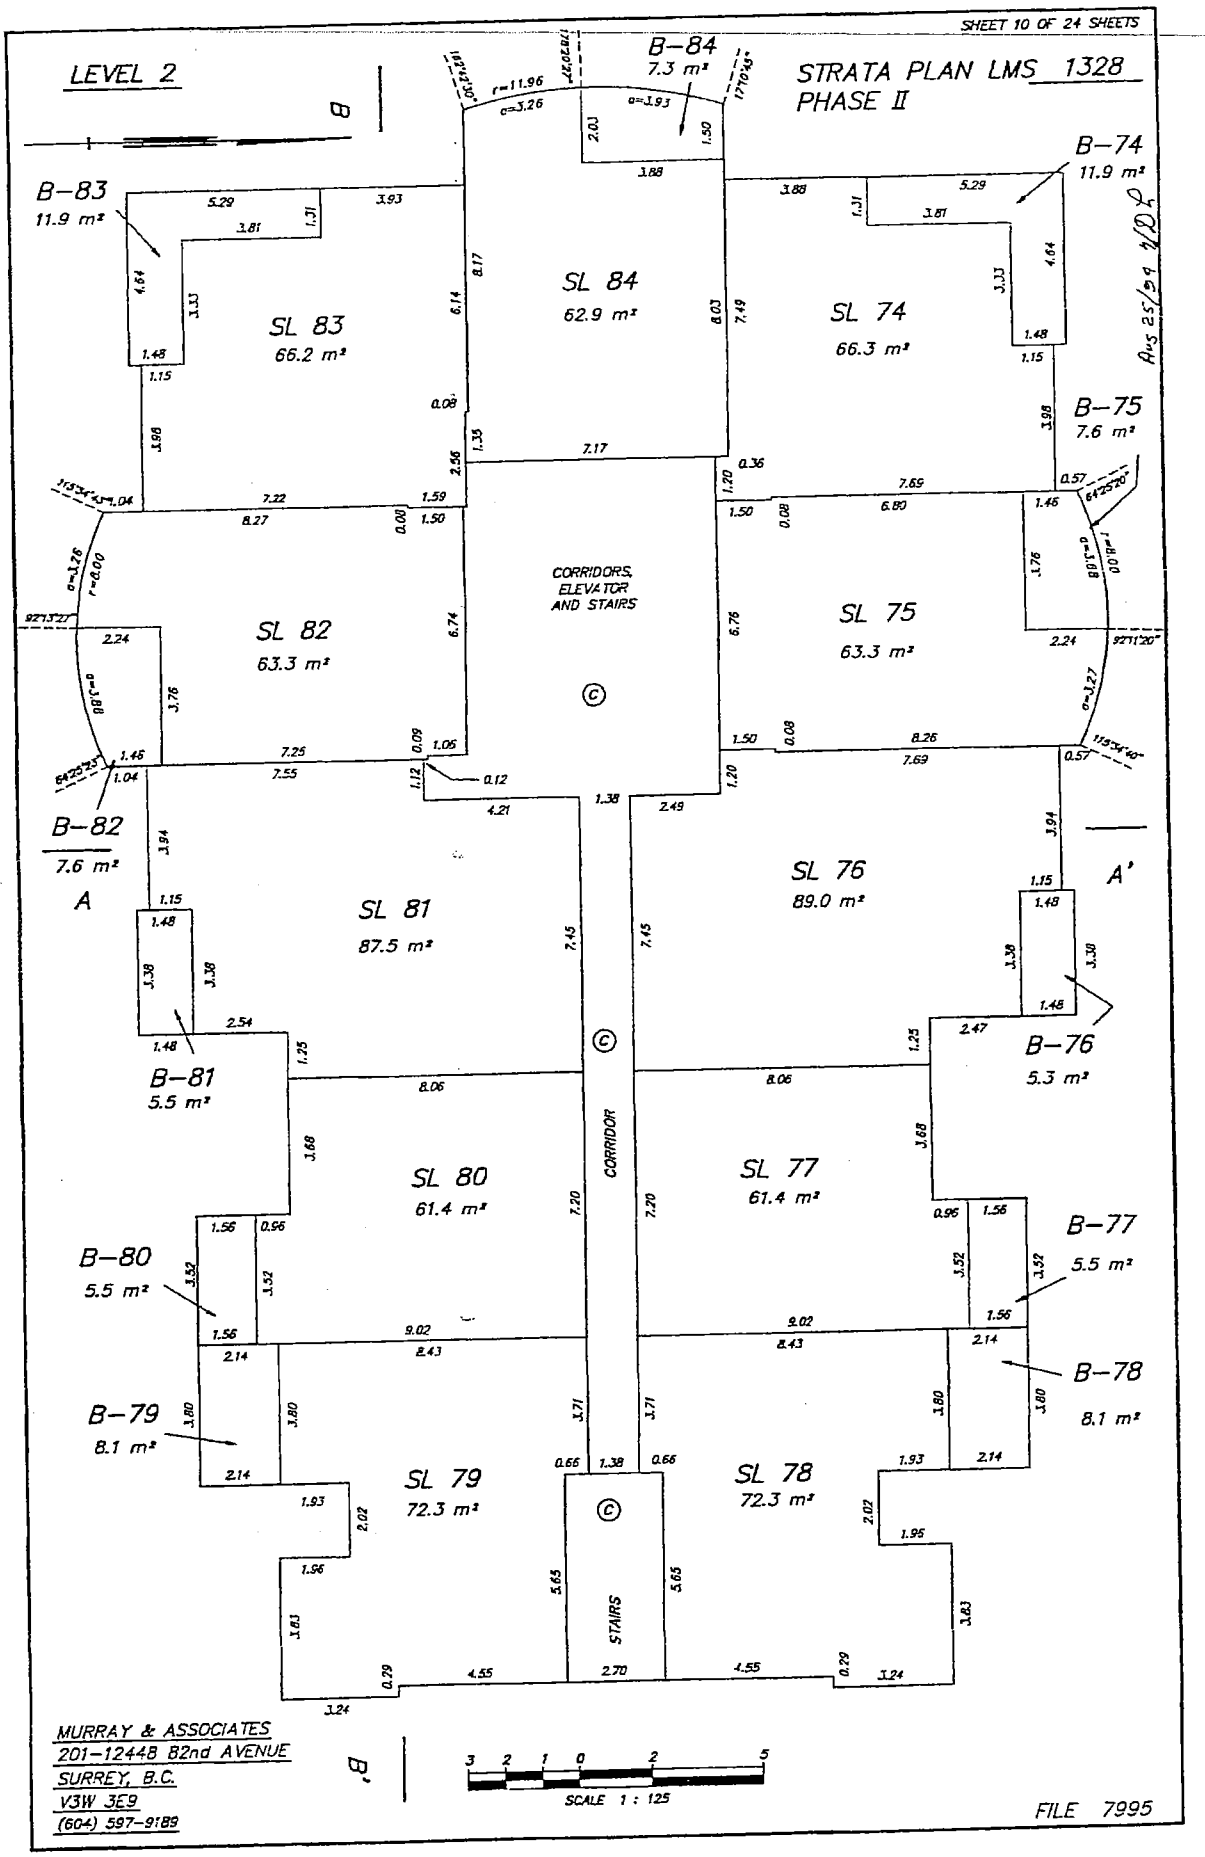

MURRAY & ASSOCIATES
201-12448 82nd AVENUE
SURREY, B.C.
V3W 3E9
(604) 597-9189

Aug 25/04

FILED LMLM91328 M70974 2004-02-17-14.01.34.850263

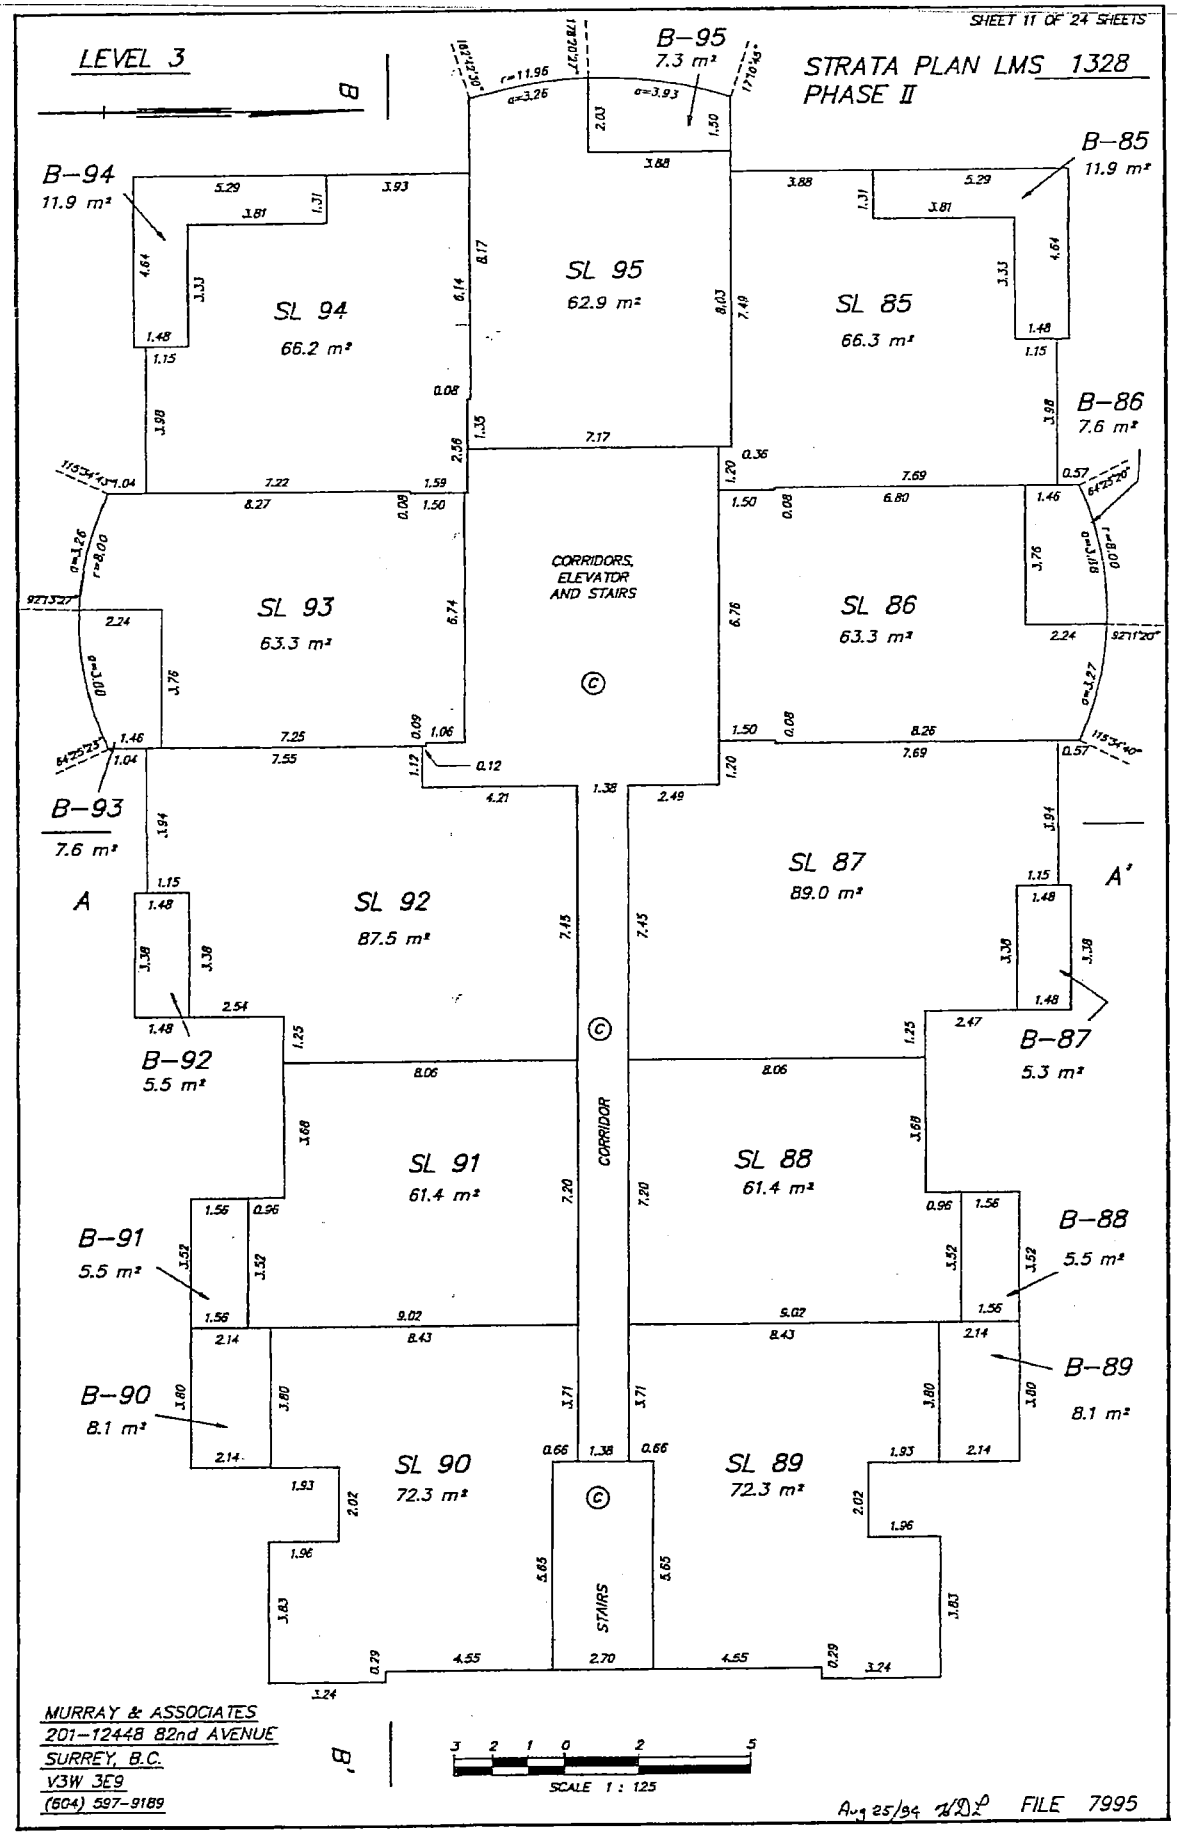

MURRAY & ASSOCIATES
201-12448 82nd AVENUE
SURREY, B.C.
V3W 3E9
(604) 597-9189

Aug 25/94 FILE 7995

FILED LMLM51320 M70974 2004-02-17-14.01.34.050263

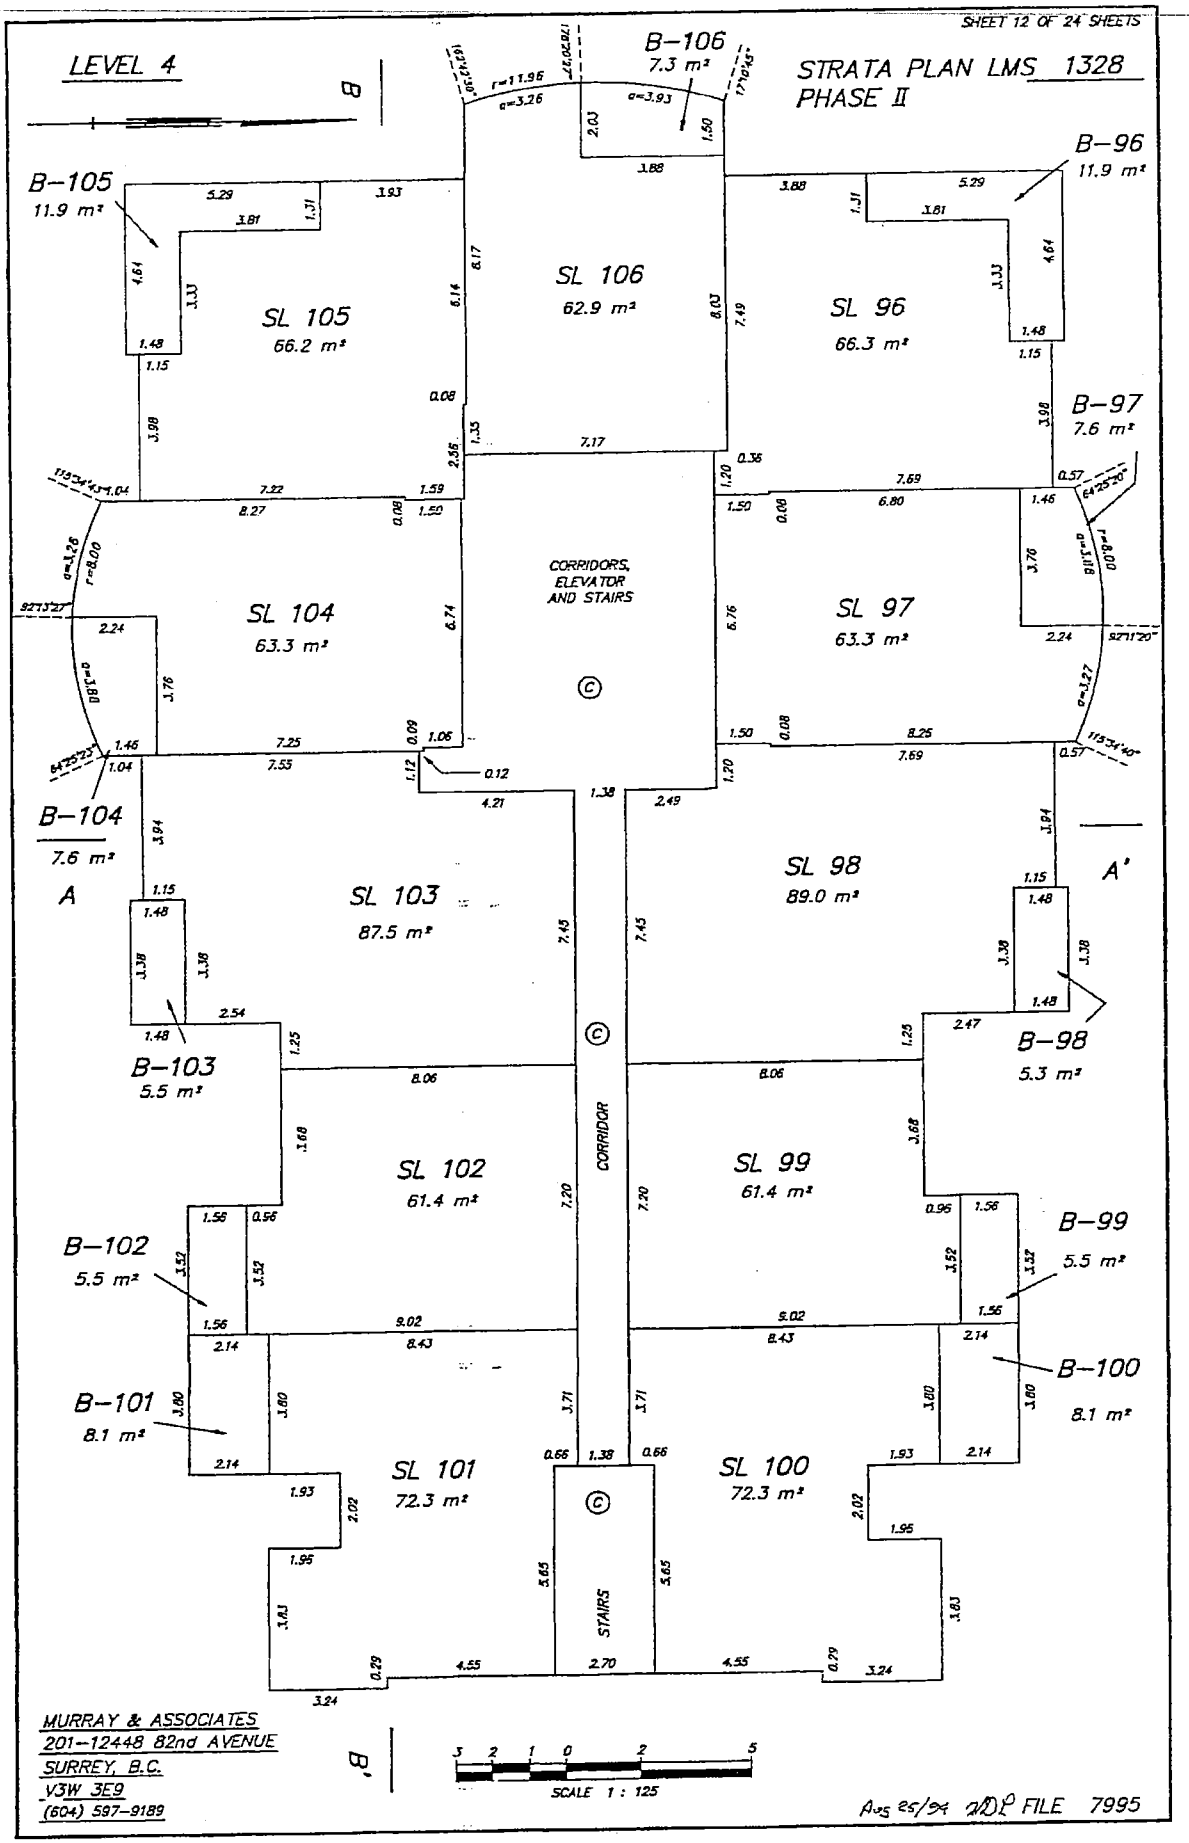

MURRAY & ASSOCIATES
201-12448 82nd AVENUE
SURREY, B.C.
V3W 3E9
(604) 597-9189

Aug 25/04 2ND FILE 7995

FILED LMLM51328 M70974 2004-02-17-14.01.34.050263

STRATA PLAN LMS 1328
PHASE II

LEVEL 5

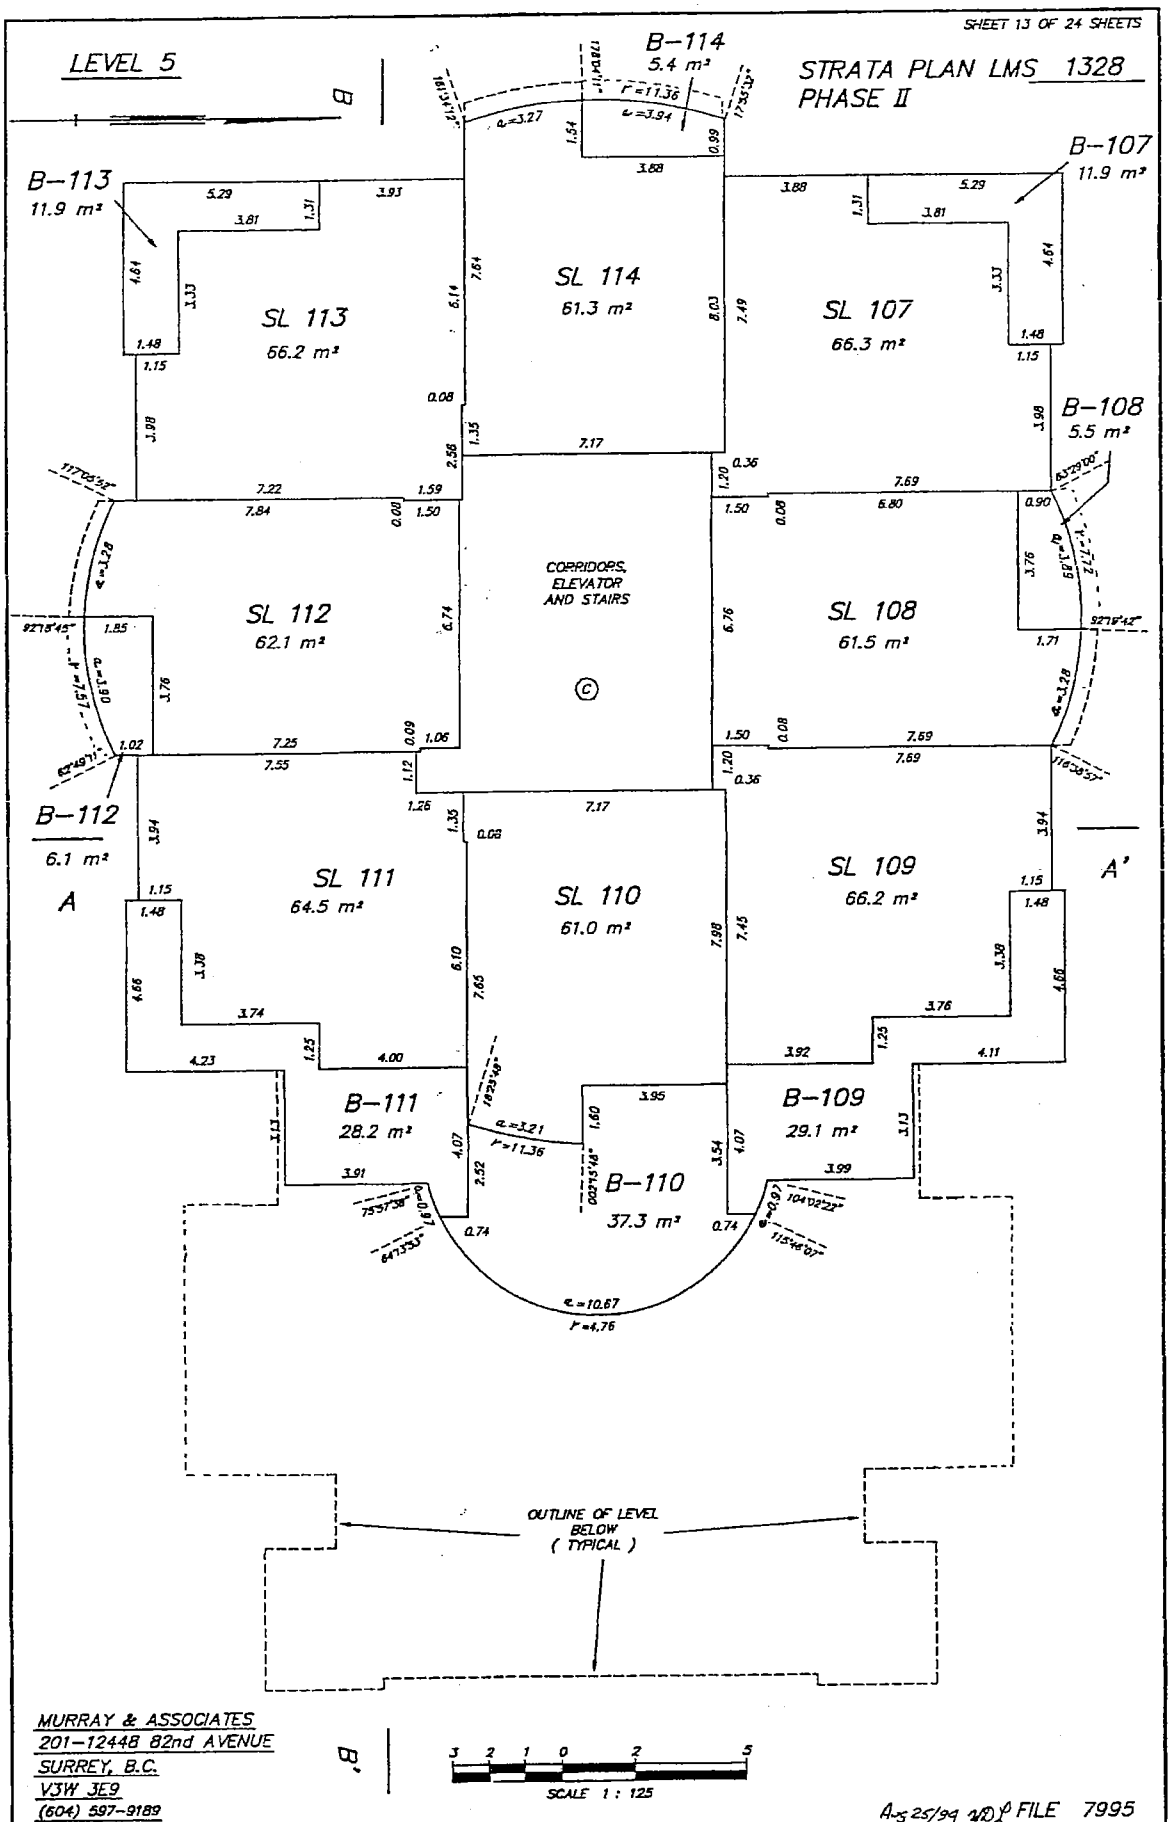

MURRAY & ASSOCIATES
201-12448 82nd AVENUE
SURREY, B.C.
V3W 3E9
(604) 597-9189

A-5 25/94 VD FILE 7995

FILED LMLM81328 M70974 2004-02-17-14.01.34.050263

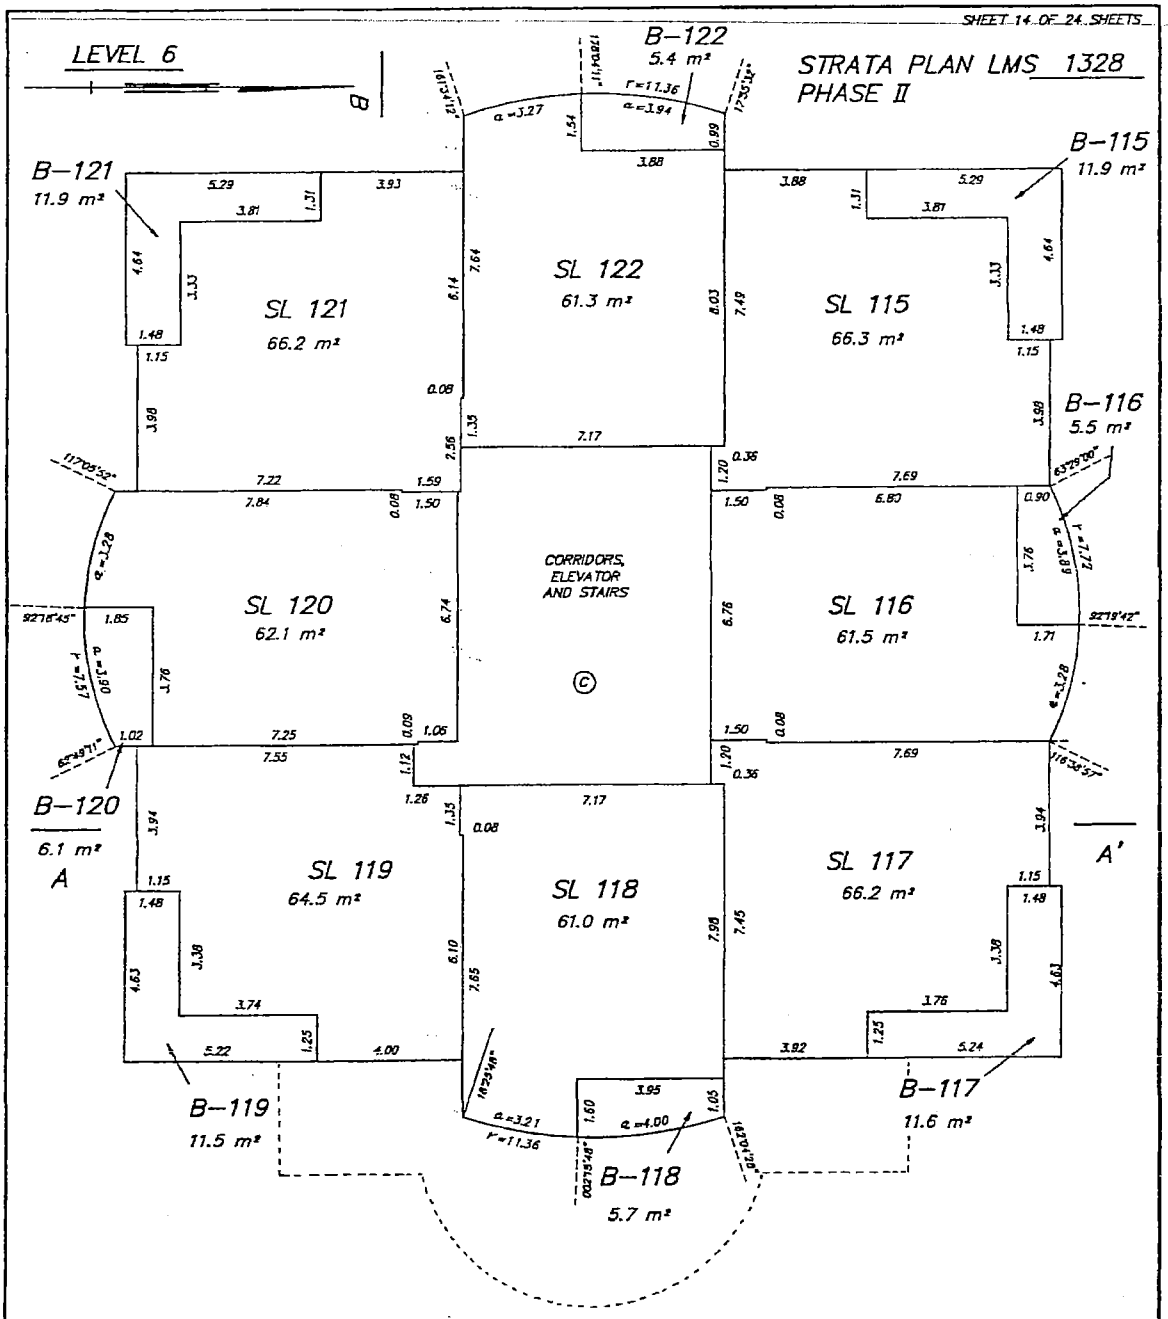

MURRAY & ASSOCIATES
201-12448 82nd AVENUE
SURREY, B.C.
V3W 3E9
(604) 597-9189

A-S 25/94 nDP FILE 7995

FILED LMLMS1328 M70974 2004-02-17-14.01.34.050263

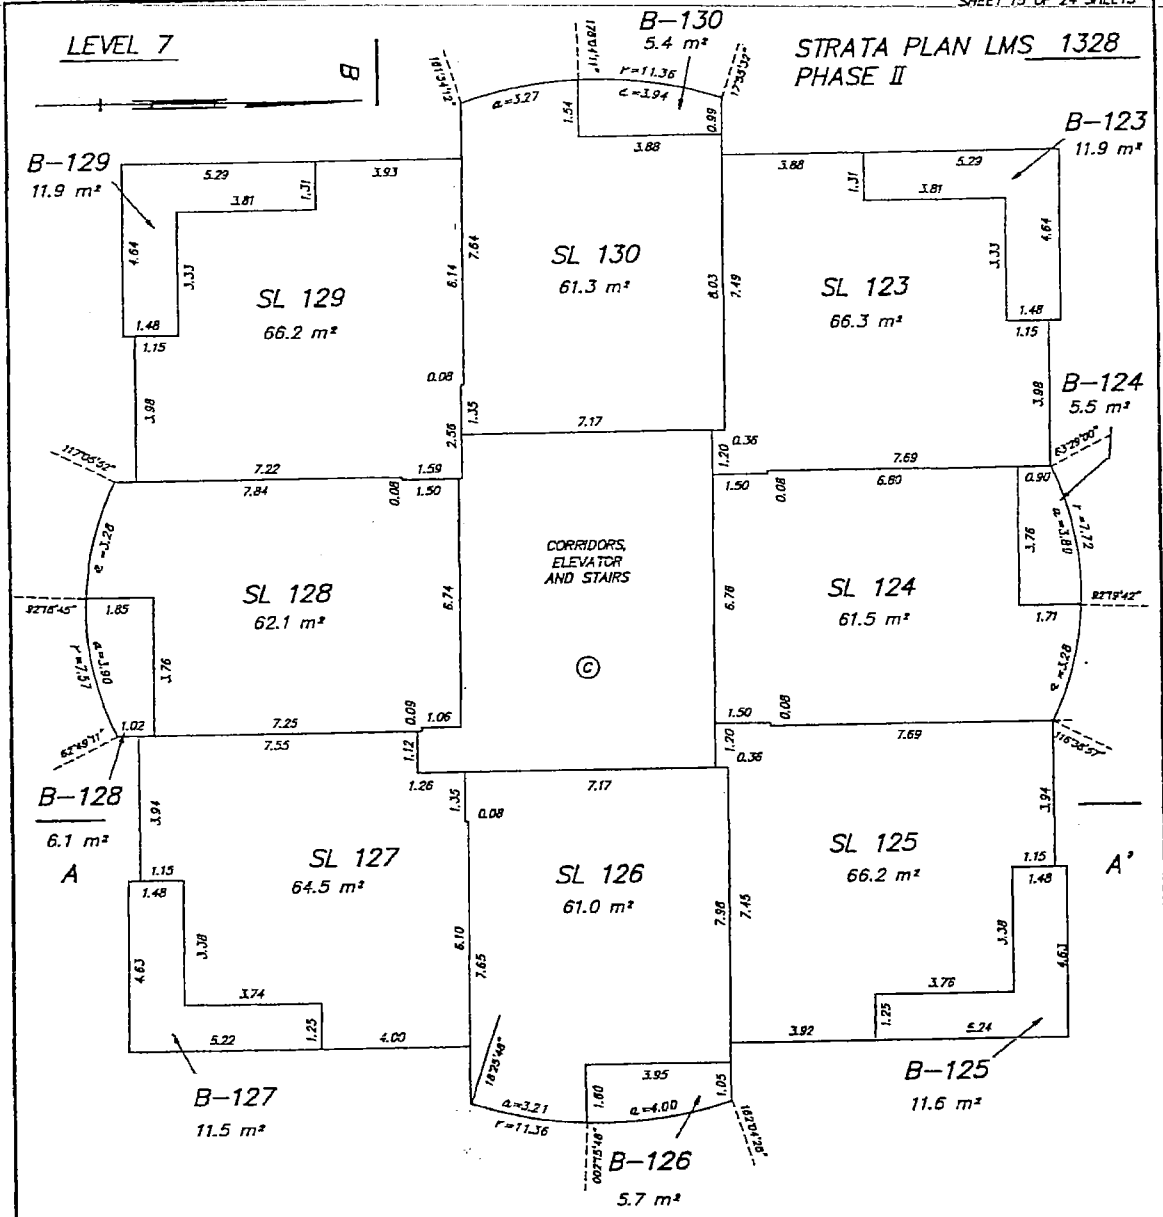

MURRAY & ASSOCIATES
201-12448 82nd AVENUE
SURREY, B.C.
V3W 3E9
(604) 597-9189

SCALE 1 : 125

A-5 25/99 DD FILE 7995

FILED LMLM51328 M70974 2004-02-17-14.01.34.850263

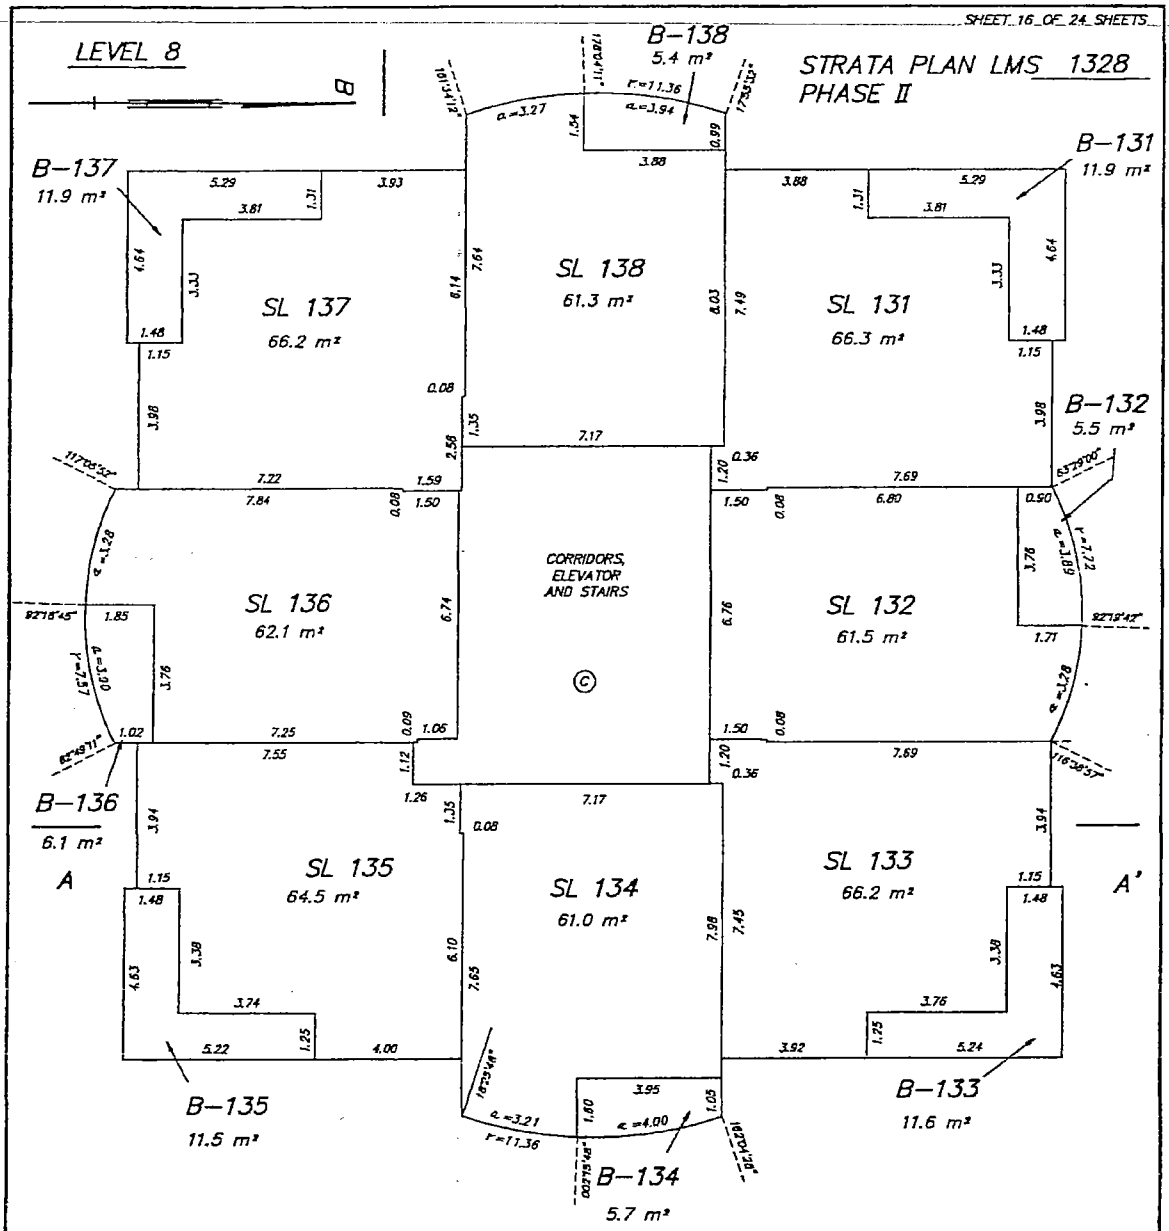

MURRAY & ASSOCIATES
201-12448 82nd AVENUE
SURREY, B.C.
V3W 3E9
(604) 597-9189

SCALE 1 : 125

FILE 7995

FILED LMLMS1328 M70974 2004-02-17-14.01.34.050263

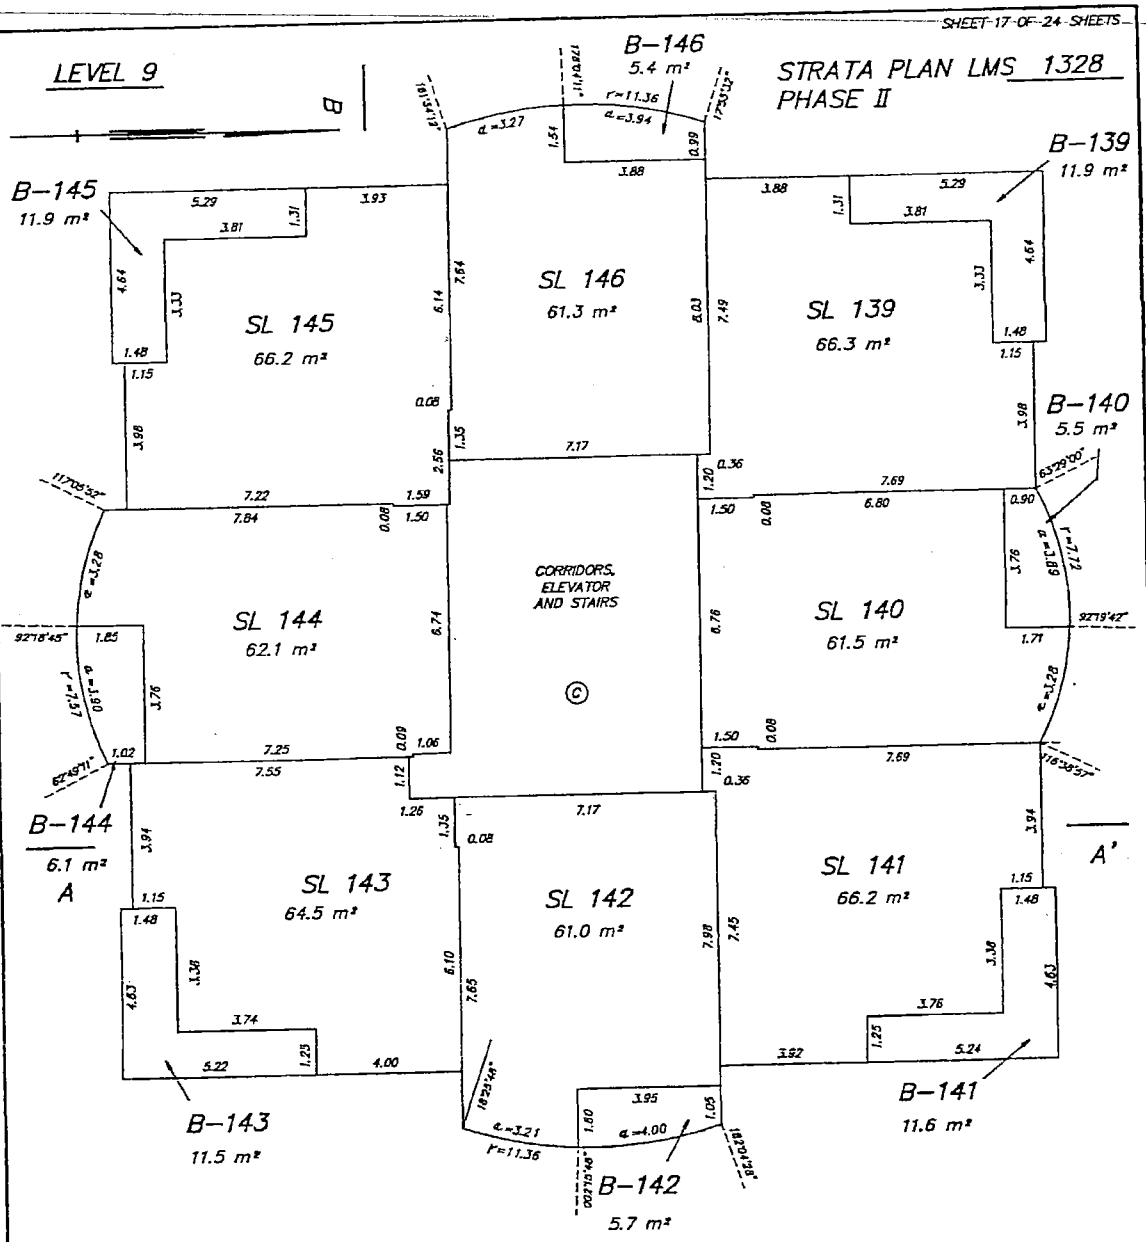

MURRAY & ASSOCIATES
201-12448 82nd AVENUE
SURREY, B.C.
V3W 3E9
(604) 597-9189

Aug 25/94 FILE 7995

FILED LMLMS1328 M70974 2004-02-17-14.01.34.050263

STRATA PLAN LMS 1328
PHASE II

LEVEL 10

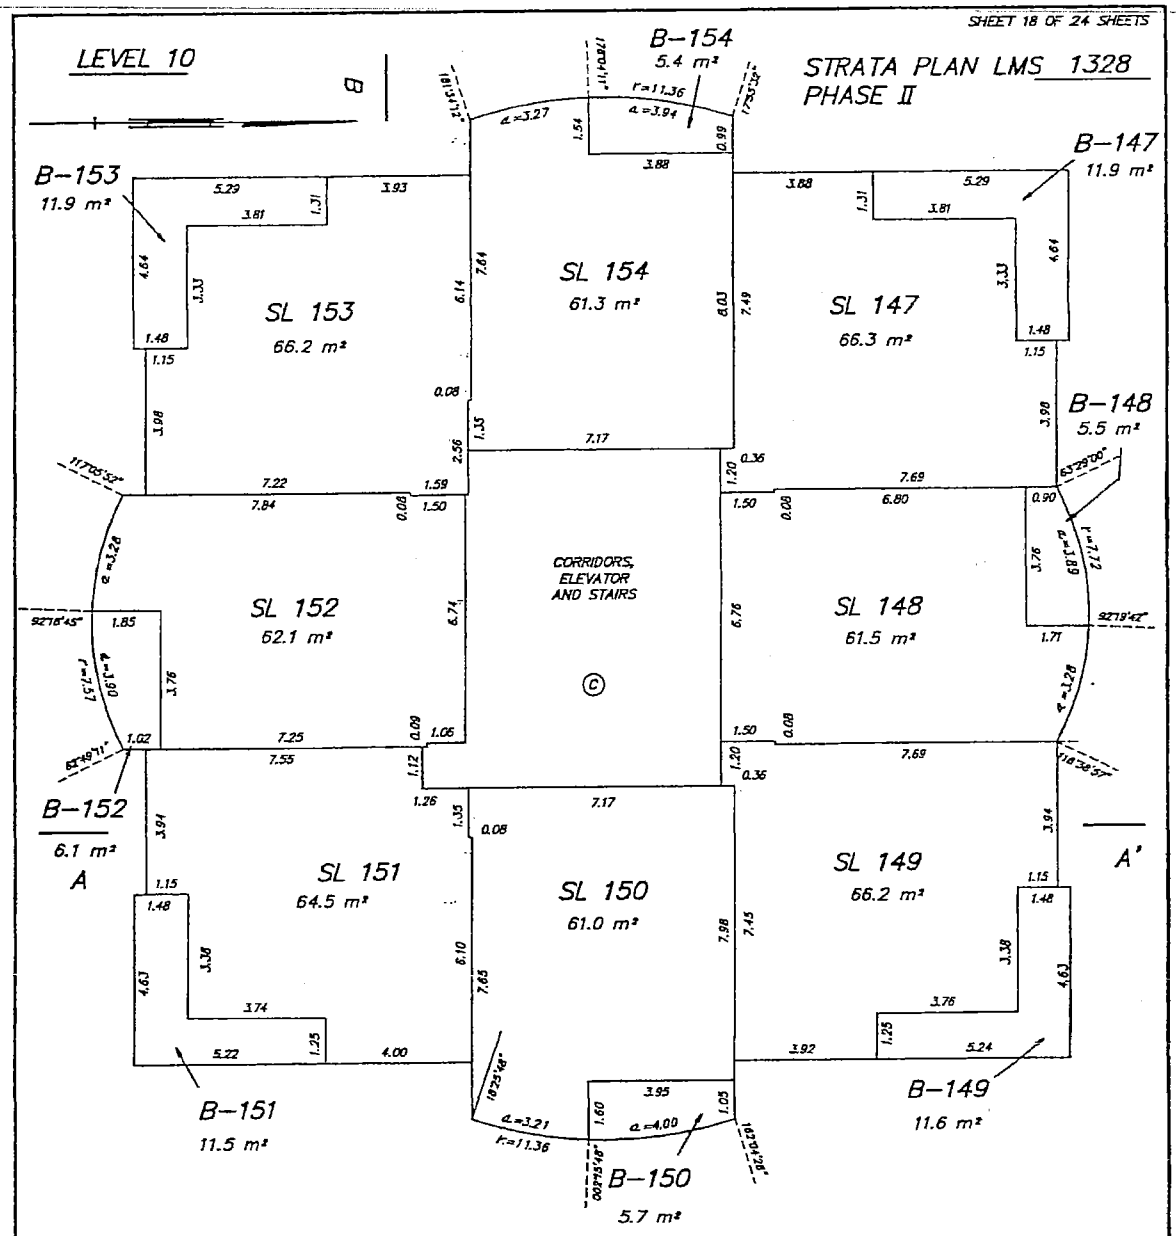

MURRAY & ASSOCIATES
201–12448 82nd AVENUE
SURREY, B.C.
V3W 3E9
(604) 597–9189

SCALE 1 : 125

Aug 25/94 FILE 7995

FILED LMLMS1328 M70974 2004-02-17-14.01.34.050263

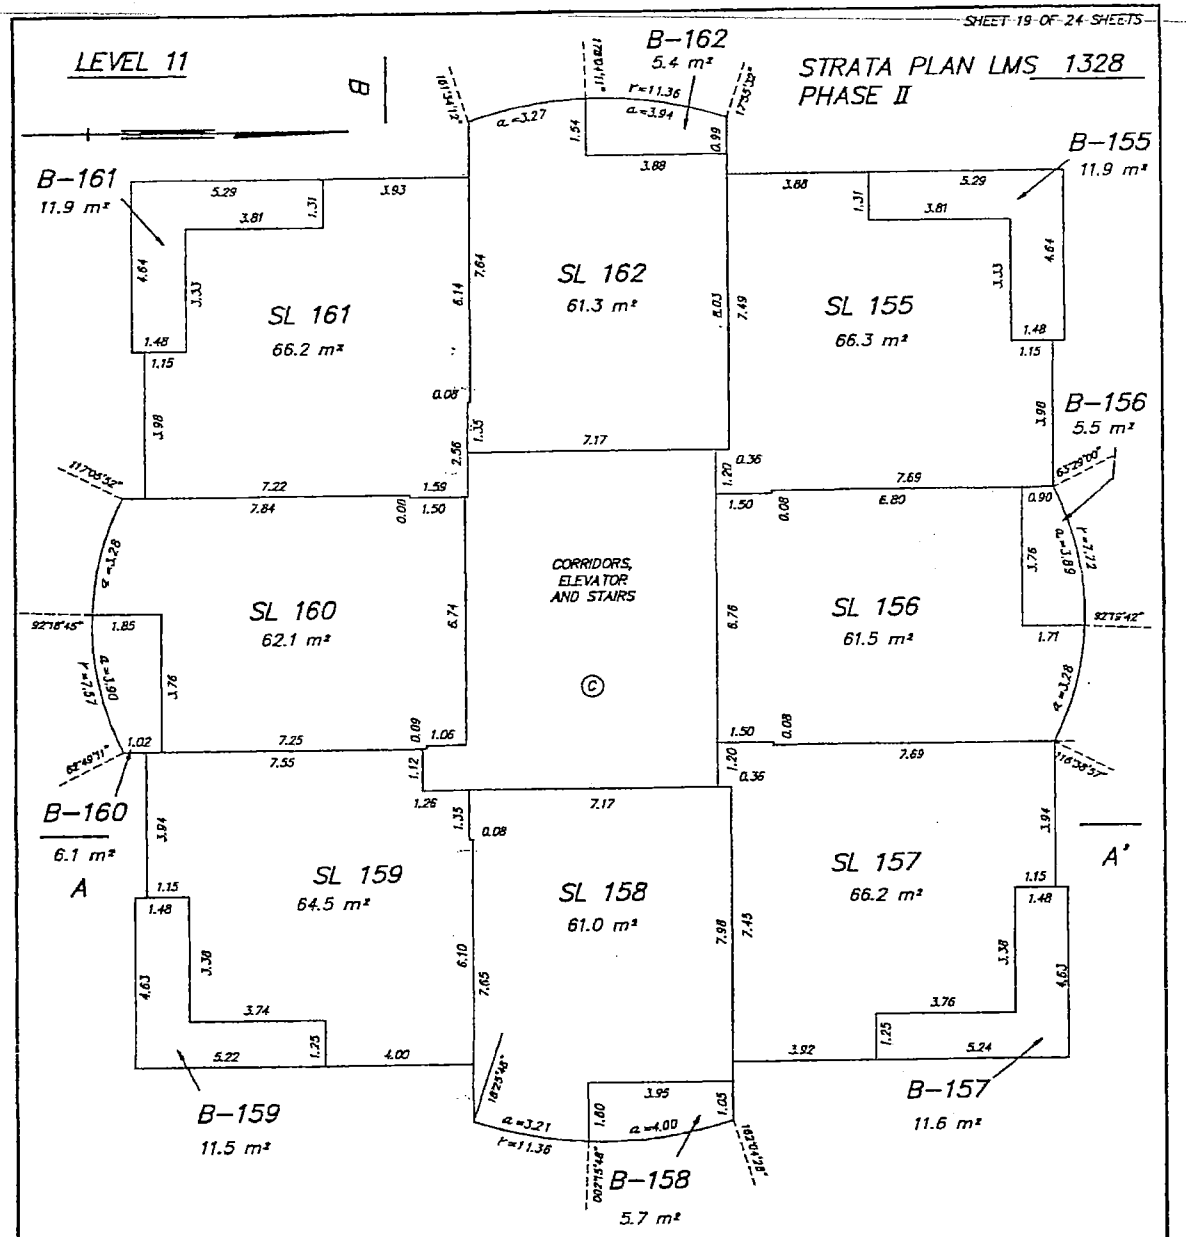

MURRAY & ASSOCIATES
201-12448 82nd AVENUE
SURREY, B.C.
V3W 3E9
(604) 597-9189

A-5 25/94 WDP FILE 7995

FILED LMLMS1328 M70974 2004-02-17-14.01.34.050263

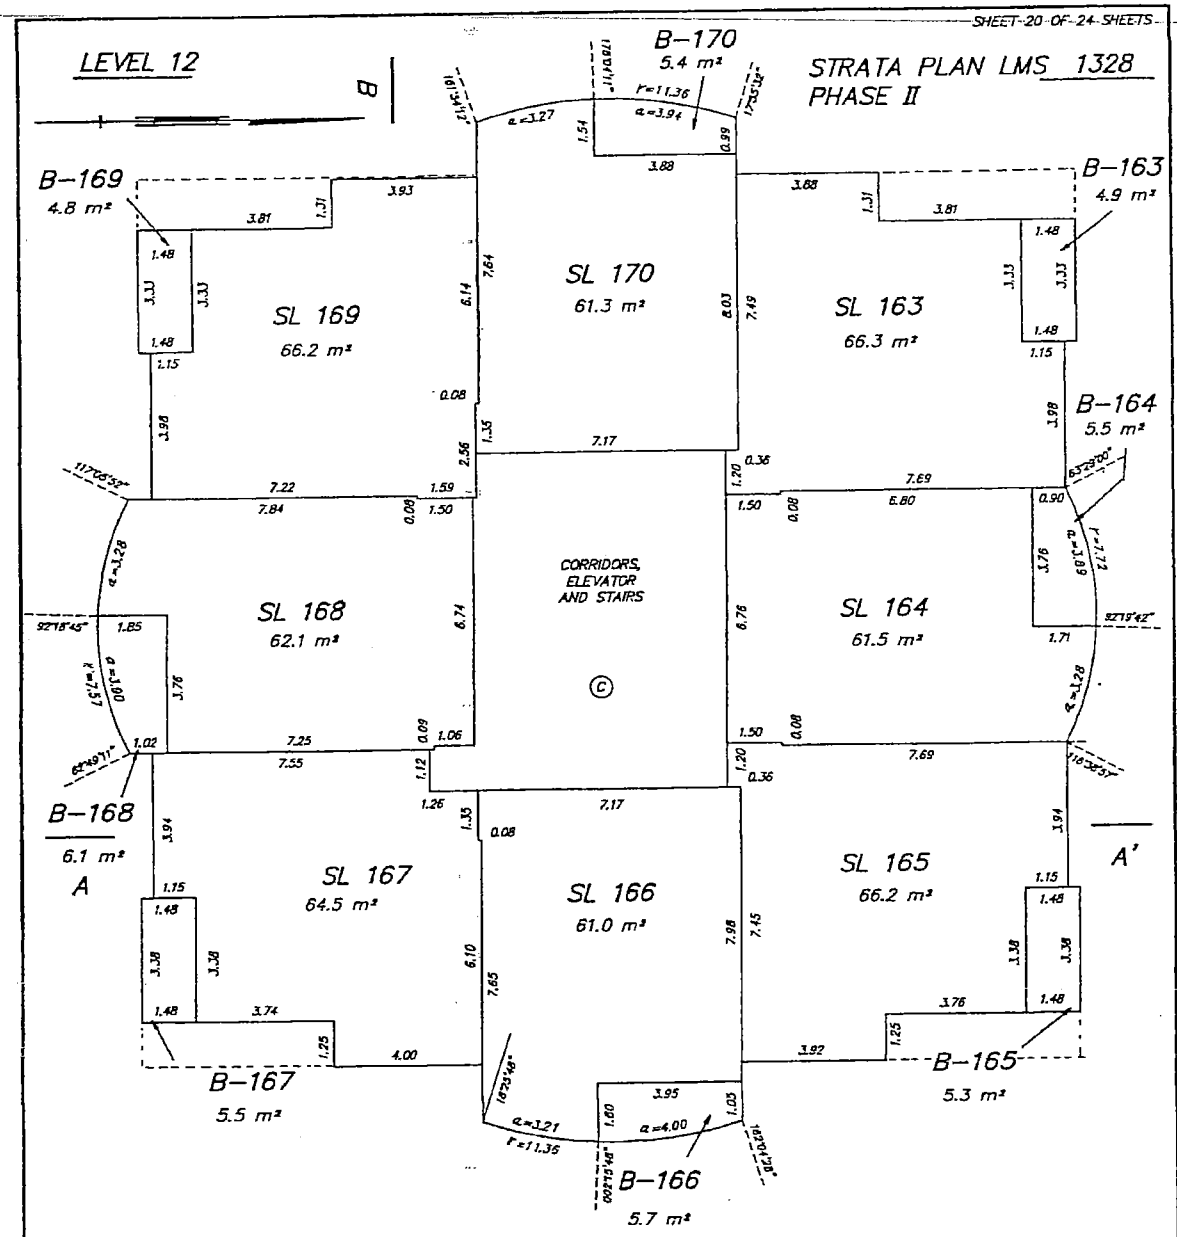

MURRAY & ASSOCIATES
201-12448 82nd AVENUE
SURREY, B.C.
V3W 3E9
(604) 597-9189

SCALE 1 : 125

Aug 25/94 FILE 7995

FILED LMLMS1328 M70974 2004-02-17-14.01.34.050263

LEVEL 13

STRATA PLAN LMS 1328
PHASE II

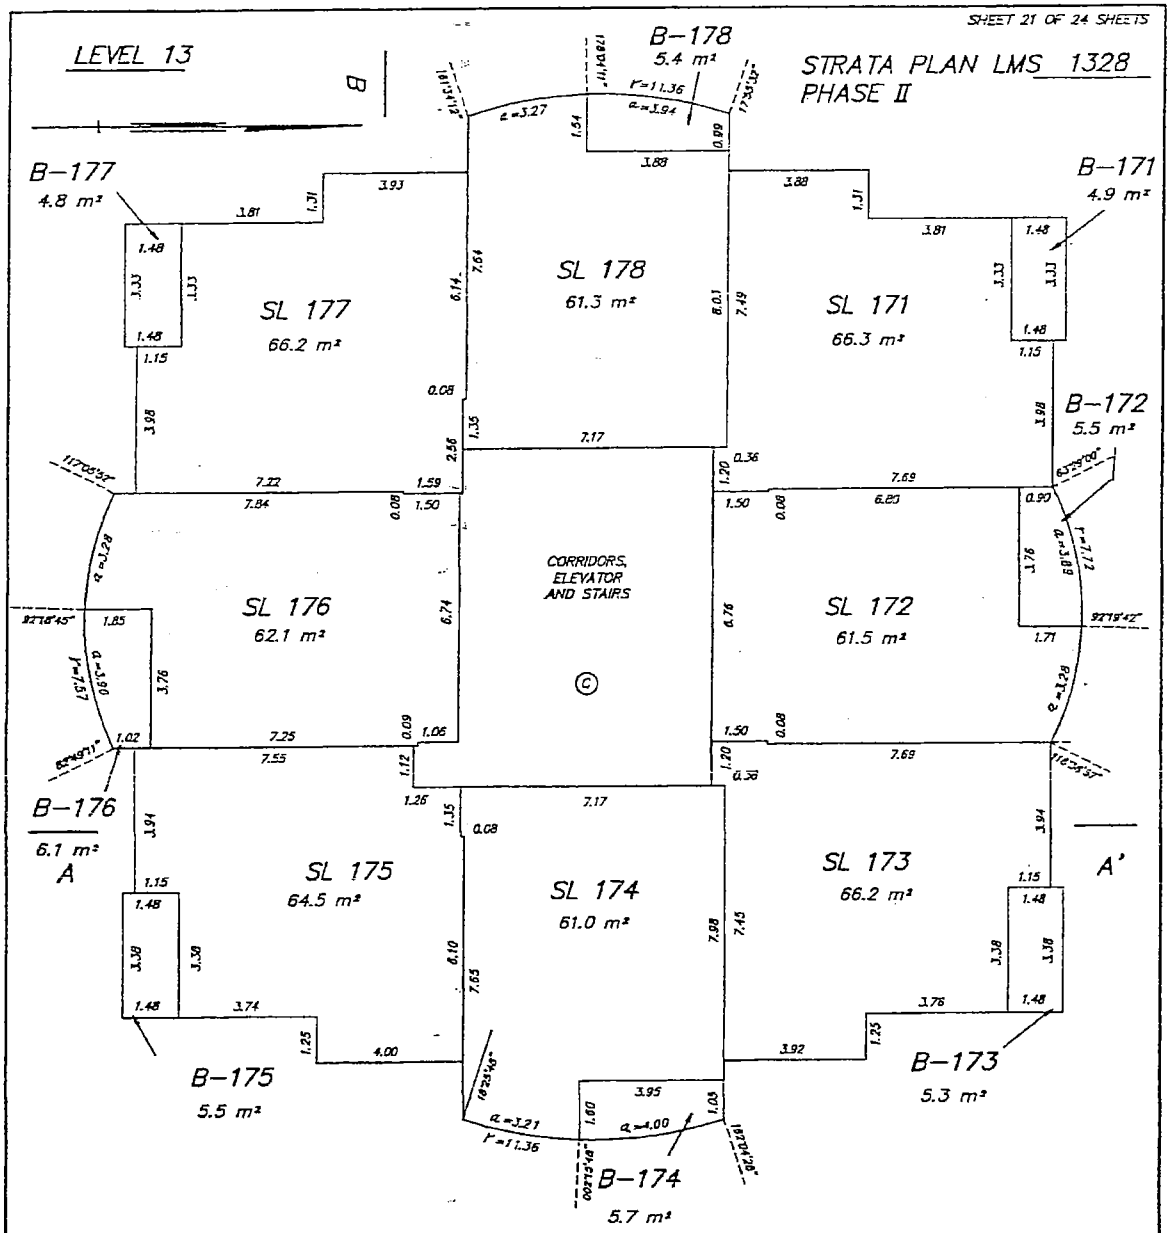

MURRAY & ASSOCIATES
201-12448 82nd AVENUE
SURREY, B.C.
V3W 3E9
(604) 597-9189

SCALE 1 : 125

Aug 25/94

FILE 7995

FILED LMLM91328 M70974 2004-02-17-14.01.34.850263

STRATA PLAN LMS 1328
PHASE II

LEVEL 14

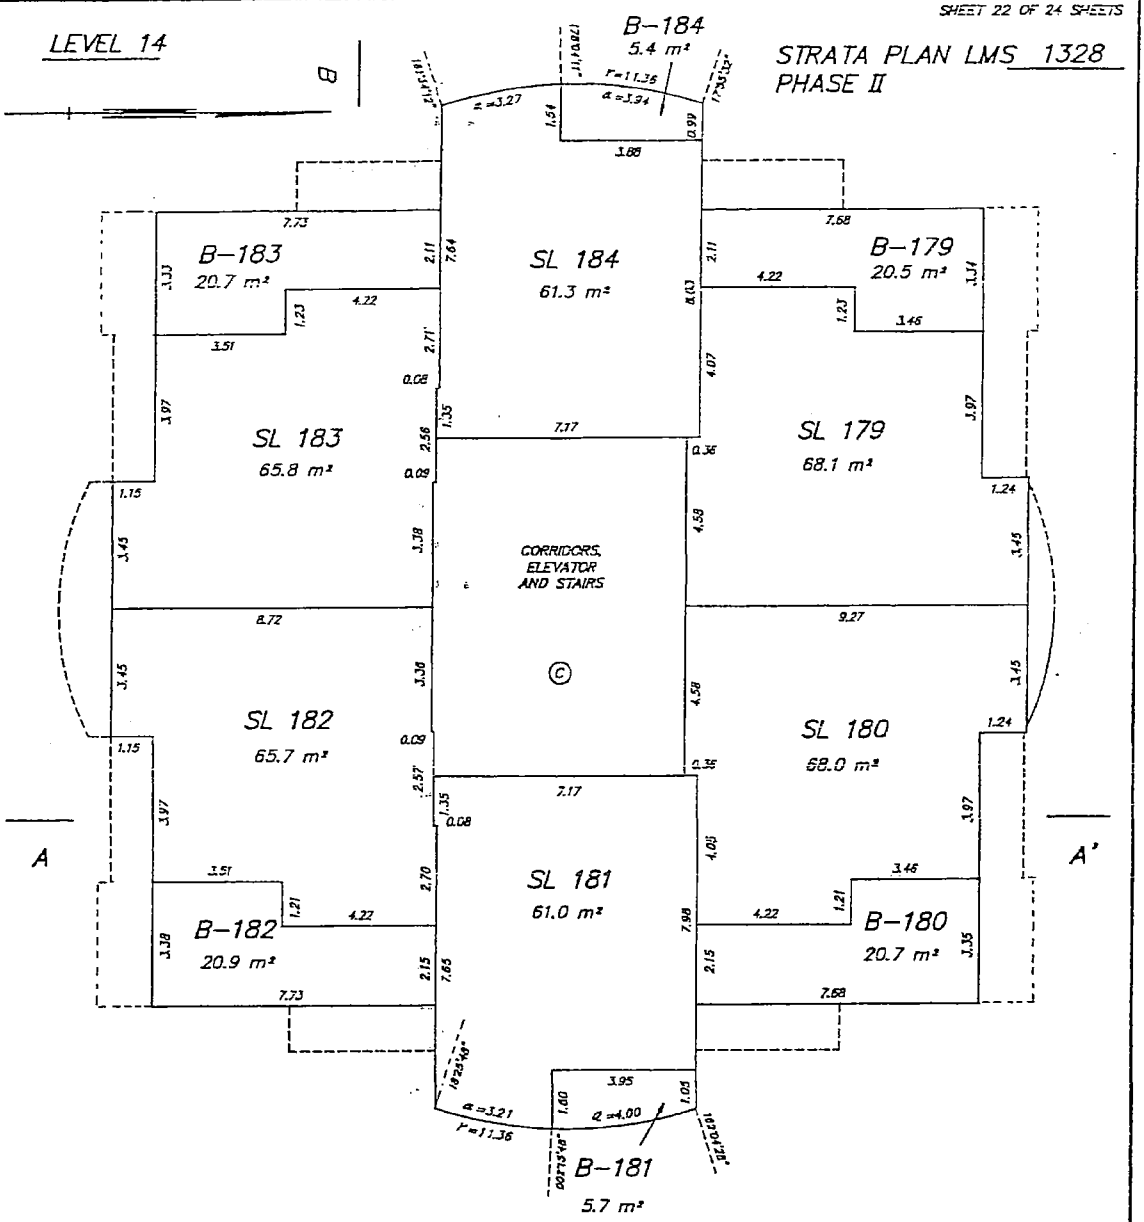

MURRAY & ASSOCIATES
201-12448 82nd AVENUE
SURREY, B.C.
V3W 3E9
(604) 597-9189

SCALE 1 : 125

Aug 25/94

FILE 7995

FILED LMLM91328 M70974 2004-02-17-14.01.34.050263

LEVEL 15

STRATA PLAN LMS 1328
PHASE II

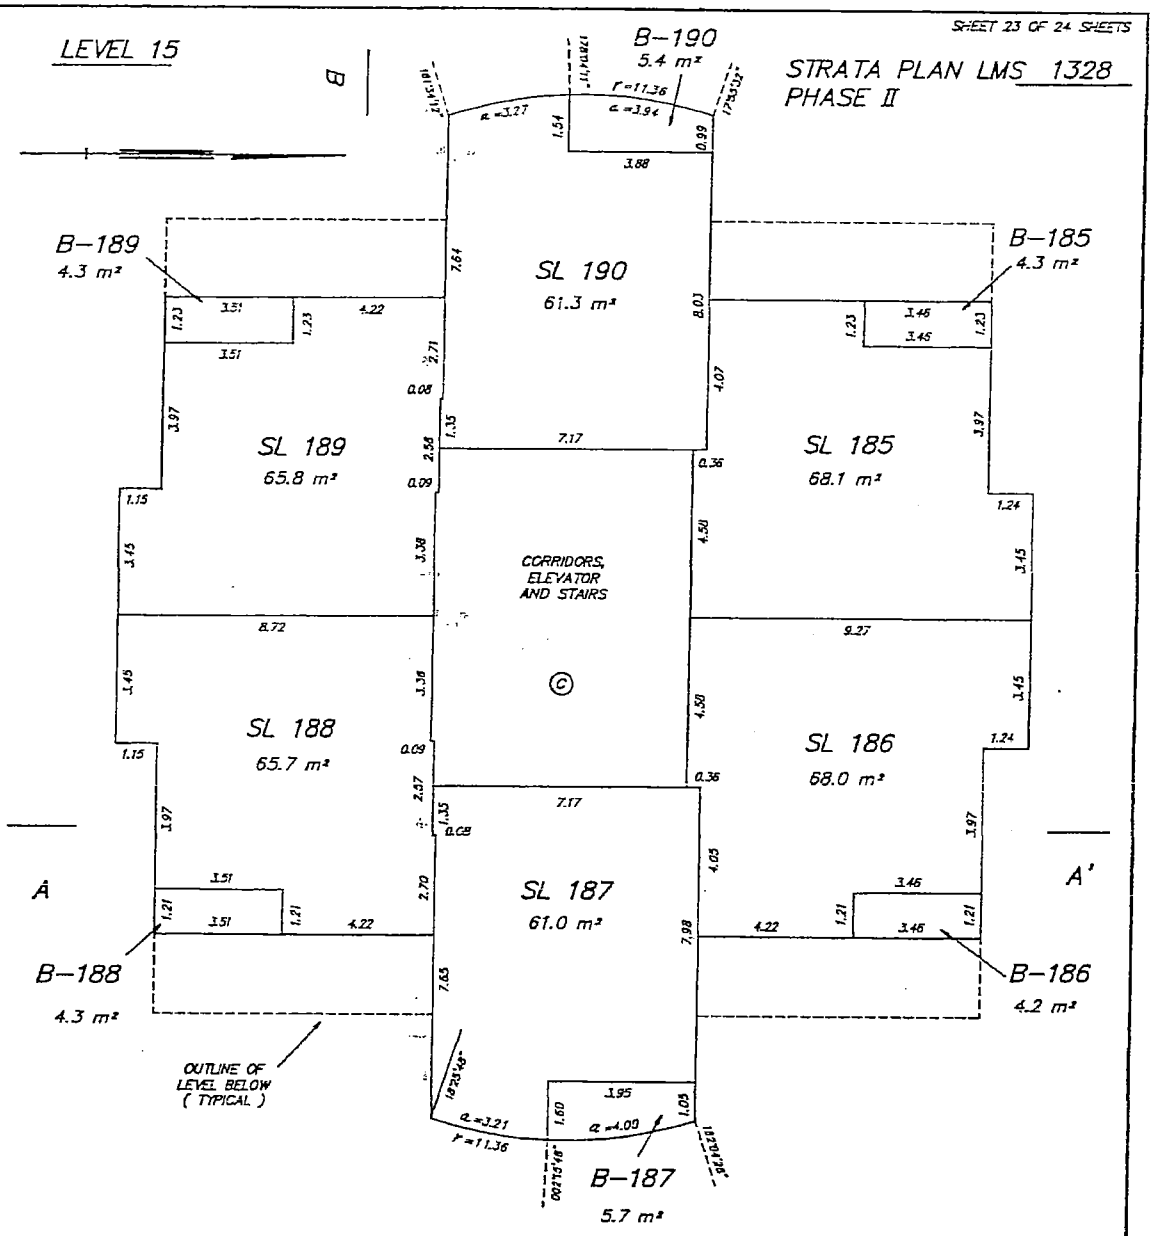

MURRAY & ASSOCIATES
201–12448 82nd AVENUE
SURREY, B.C.
V3W 3E9
(604) 597–9189

Aug 25/94 n/D FILE 7995

FILED LMLM81328 M70974 2004-02-17-14.01.34.850263

LEVEL 16

STRATA PLAN LMS 1328
PHASE II

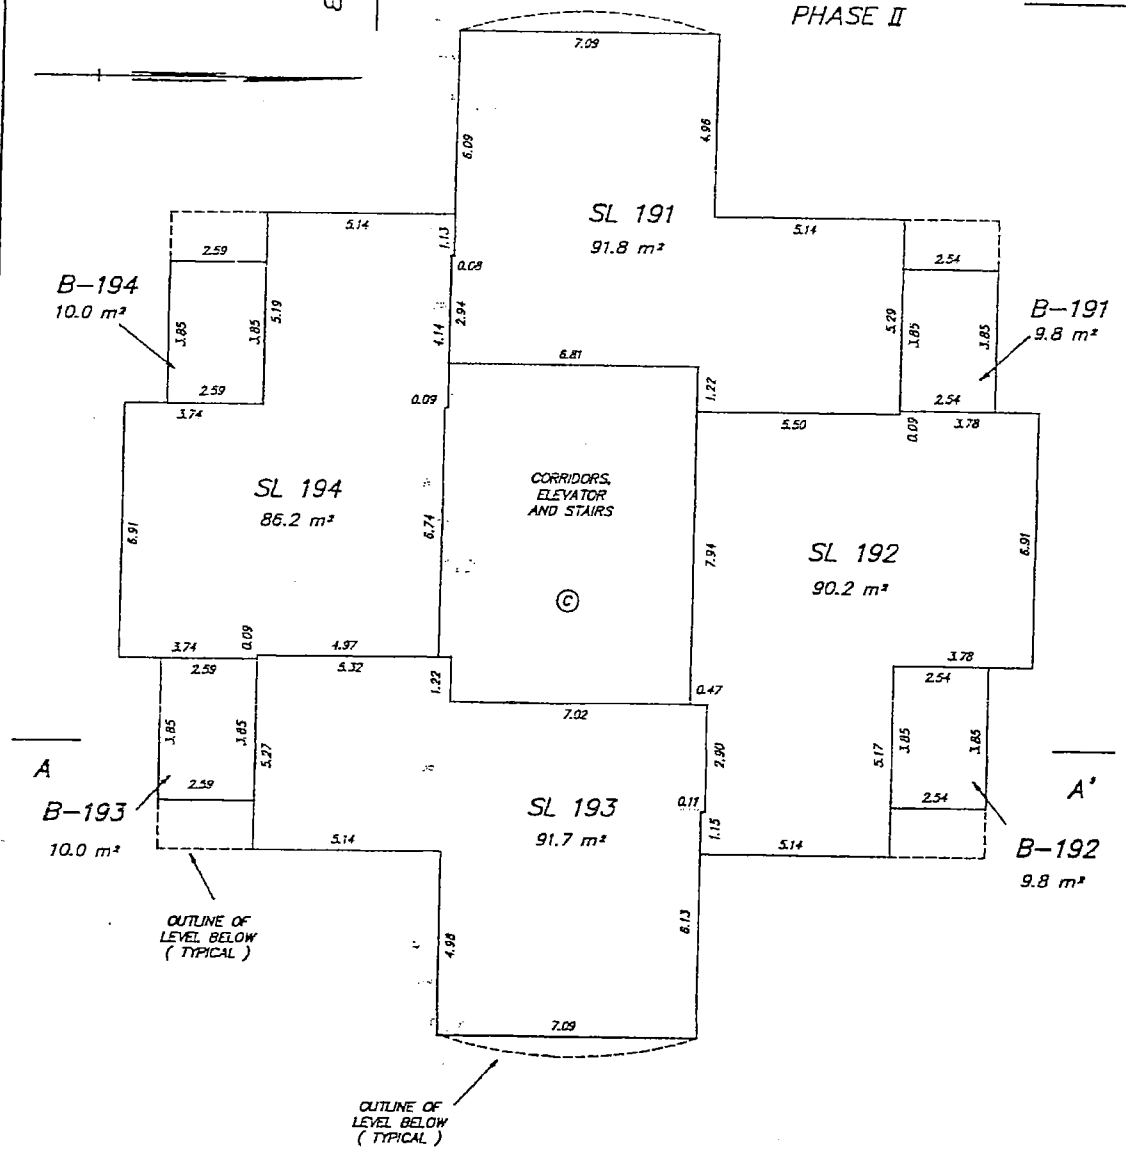

MURRAY & ASSOCIATES
201-12448 82nd AVENUE
SURREY, B.C.
V3W 3E9
(604) 597-9189

A-525/94 LMD FILE 7995

FILED LMLMS1328 M70974 2004-02-17-14.01.34.850263